

WATER WELL PLUGGING RECORD

Form WWC-5P

KSA 82a-1212

ID NO.

1 LOCATION OF WATER WELL:

Fraction

1/4

1/4

1/4

County: *Gray*

Section Number

25

Township Number

27T

28S

Range Number

R30

E

W

Street/Rural Address of Well Location; if unknown, distance & direction from nearest town or intersection: If at owner's address, check here

Global Positioning Systems (GPS) information:

Latitude: _____ (in decimal degrees)

Longitude: _____ (in decimal degrees)


Elevation: _____

Horizontal Datum: WGS84, NAD83, NAD27

Collection Method:

 GPS unit (Make/Model): _____ Digital Map/Photo, Topographic Map, Land SurveyEst. Accuracy: < 3 m, 3-5 m, 5-15 m, > 15 m2 WATER WELL OWNER: *Hamilton Bros*RR#, St. Address, Box #: *Po Box 149*City, State ZIP Code: *Ensign, KS 67841*

3 MARK WELL'S LOCATION WITH AN "X" IN SECTION BOX:

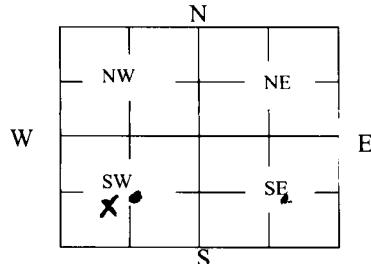

4 DEPTH OF WELL

340

ft.

WELL'S STATIC WATER LEVEL *-125* ft

WELL WAS USED AS:

Domestic
 Irrigation
 Feedlot
 Industrial

Public Water Supply
 Oil Field Water Supply
 Domestic (Lawn & Garden)
 Air Conditioning

Dewatering
 Monitoring
 Injection Well
 Other _____

Was a chemical/bacteriological sample submitted to Department? Yes No

5 TYPE OF BLANK CASING USED:

Steel
 PVC

RMP (SR)
 ABS

Wrought
 Asbestos-Cement

Fiberglass
 Concrete Tile

 Other (Specify below) _____Blank casing diameter *15* in. Was casing pulled? Yes No If yes, how much _____Casing height above or below land surface *8 ft.* in. → *dug down 8 ft cutoff*

6 GROUT PLUG MATERIAL:

 Neat cement Cement grout Bentonite Other _____Grout Plug Intervals: From *0* ft. to *18* ft., From _____ ft. to _____ ft., From _____ ft. to _____ ft.

What is the nearest source of possible contamination:

Septic tank
 Sewer lines
 Watertight sewer lines
 Lateral lines
 Cess pool

Seepage pit
 Pit privy
 Sewage lagoon
 Feedyard
 Livestock pens

Fuel storage
 Fertilizer storage
 Insecticide storage
 Abandoned water well
 Oil well/Gas well

 Other (specify below) _____Direction from well? *West*
How many feet? *1500 ft*

FROM	TO	PLUGGING MATERIALS	FROM	TO	PLUGGING MATERIALS
0	8'ft	<i>Top soil</i>			
8'	18'	<i>bentonite</i>			
18'	340'	<i>sand</i>			

7 CONTRACTOR'S OR LANDOWNER'S CERTIFICATION: This water well was plugged under my jurisdiction and was completed on (mo/day/year) _____ and this record is true to the best of my knowledge and belief. Kansas Water Well Contractor's License No. _____ This Water Well Record was completed on (mo/day/year) *6-6-08* under the business name of _____ by (signature) *Terry Hamilton*

Send one white copy to Kansas Department of Health & Environment, Geology Section, 1000 SW Jackson Street, Ste. 420, Topeka, KS 66612-1367. Send one copy to WATER WELL OWNER and retain one for your records.

Visit us at <http://www.kdheks.gov/waterwell/index.html> Telephone 785-296-5524.