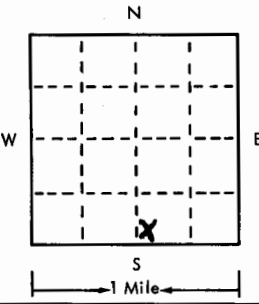


USE TYPEWRITER OR BALL
POINT PEN-PRESS FIRMLY,
PRINT CLEARLY.

WATER WELL RECORD
KSA 82a-1201-1215

T R EW sec 1/4 1/4 1/4 No.

Kansas State Dept. Of Health
(Water Well Contractors)
Forbes-Bldg, 740
Topeka, Kansas 66620

1 Location of well:	County Haskell	Township name SW, SW, SE	Fraction 13	Section number 285	Town number 31 W	Range number
Distance and direction from nearest town or city: Approx. 8 mi N. and 10.5 mi E Street address of well location if in city: from Sublette			3 Owner of well: Ralph T Dana Leonard Address: Copeland, Ks			
Locate with "X" in section below: 			Sketch map:			
2 Type and color of material			From	To	4 Well depth: 356 ft. Date of completion 20 Aug 75 Well diameter 28 in.	
Well drilled near the site of TH 1-75 (see attached), which is 500' N. of SW cor of SE 1/4, Sec 13, 28-31, Haskell Co.					5 <input type="checkbox"/> Cable tool <input type="checkbox"/> Rotary <input type="checkbox"/> Driven <input type="checkbox"/> Dug <input type="checkbox"/> Hollow rod <input type="checkbox"/> Jetted <input type="checkbox"/> Bored <input checked="" type="checkbox"/> Reverse rotary	
					6 Use: <input type="checkbox"/> Domestic <input type="checkbox"/> Public supply <input type="checkbox"/> Industry <input checked="" type="checkbox"/> Irrigation <input type="checkbox"/> Air conditioning <input type="checkbox"/> Commercial <input type="checkbox"/> Test well	
					7 Casing: Material STL Height: above Acrow Threaded <input type="checkbox"/> Welded <input checked="" type="checkbox"/> Surface 12 in. Dig. Weight 37 lbs./ft. 16 in. to 356 ft. depth Drive shoe? <input type="checkbox"/> Yes <input checked="" type="checkbox"/> No in. to in. ft. depth	
					8 Screen: Manufacturer Foster T Brown Type lower T mill slot 16" Slot/gauze 1/8 Length 182' Set between 174 ft. and 356 ft. Fittings: 5.6 - 1.1 mm Gravel pack <input checked="" type="checkbox"/> Yes <input type="checkbox"/> No Size range of material	
					9 Static water level: 170 ft. below land surface Date 4 Mar 75	
					10 Pumping level below land surfaces: 190 ft. after 1 hrs. pumping 2180 g.p.m. 204 ft. after 1 hrs. pumping 2560 g.p.m. Estimated maximum yield 3000 g.p.m.	
					11 Water sample submitted: <input type="checkbox"/> Yes <input checked="" type="checkbox"/> No Date	
					12 Well head completion: <input type="checkbox"/> Pitless adapter <input checked="" type="checkbox"/> inches above grade	
					13 Well grouted? <input checked="" type="checkbox"/> Yes <input type="checkbox"/> No <input type="checkbox"/> Neat cement <input checked="" type="checkbox"/> Bentonite <input type="checkbox"/> Depth: From 0 ft. to 10 ft.	
					14 Nearest source of possible contamination: Ln R ft. Direction Type Well disinfected upon completion? <input checked="" type="checkbox"/> Yes <input type="checkbox"/> No	
15 Pump: Manufacturer's name Layne Model number M 14 HP 200 Volts Length of drop pipe 240 ft. capacity 3000 g.p.m. Type: <input type="checkbox"/> Submersible <input checked="" type="checkbox"/> Turbine <input type="checkbox"/> Jet <input type="checkbox"/> Reciprocating <input type="checkbox"/> Centrifugal <input type="checkbox"/> Other						
16 Remarks: elevation Topography: <input type="checkbox"/> Hill <input type="checkbox"/> Slope <input checked="" type="checkbox"/> Upland <input type="checkbox"/> Valley			17 Water well contractor's certification: This well was drilled under my jurisdiction and this report is true to the best of my knowledge and belief. Layne-Western Co 150 Business name License No. Address Garden City Signed R. L. [Signature] Date 11 Sep 75 Authorized representative			

