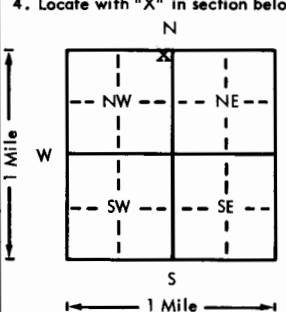


USE TYPEWRITER OR BALL
POINT PEN-PRESS FIRMLY,
PRINT CLEARLY.

WATER WELL RECORD
KSA 82a-1201-1215

Kansas Department of Health and
Environment-Division of Environment
(Water well Contractors)
Topeka, Kansas 66620

1. Location of well:		County Haskell	Fraction NE 1/4 NE 1/4 NW 1/4	Section number 20	Township number T 28S	Range number S R 31W E/W
2. Distance and direction from nearest town or city: From Sublette go 6 North, 5 East, 3 North, & 2 1/2 East. Street address of well location if in city:				3. Owner of well: Herschel Webber R.R. or street: 201 N. Murphy City, state, zip code: Sublette, Kansas 67877		
4. Locate with "X" in section below:  Sketch map: NE Corner of the NW 1/4, Sec. 20, T28S, R31W, Haskell County, Kansas				6. Bore hole dia. 28 in. Completion date _____ Well depth 456 ft. 12-28-77		
5. Type and color of material				7. Cable tool <input type="checkbox"/> Rotary <input type="checkbox"/> Driven <input type="checkbox"/> Dug <input type="checkbox"/> <input type="checkbox"/> Hollow rod <input type="checkbox"/> Jetted <input type="checkbox"/> Bored <input checked="" type="checkbox"/> Reverse rotary		
				8. Use: <input checked="" type="checkbox"/> Domestic <input type="checkbox"/> Public supply <input type="checkbox"/> Industry <input checked="" type="checkbox"/> Irrigation <input type="checkbox"/> Air conditioning <input type="checkbox"/> Stock <input type="checkbox"/> Lawn <input type="checkbox"/> Oil field water <input type="checkbox"/> Other		
Tan clay, sand streaks				9. Casing: Material Steel Height: Above or below Threaded <input type="checkbox"/> Welded <input checked="" type="checkbox"/> Surface 12 in. RMP <input type="checkbox"/> PVC <input type="checkbox"/> Weight 37 lbs./ft. Dia. 16 in. to 222 ft. depth Wall Thickness: inches or Dia. <input type="checkbox"/> in. to <input type="checkbox"/> ft. depth gage No. 219		
				10. Screen: Manufacturer's name Doerr, Foster Louver Type Millslot Dia. 16 Slot/gauze 1/8 Length 234 Set between 222 ft. and 456 ft. ft. and <input type="checkbox"/> ft. Gravel pack? <input checked="" type="checkbox"/> Yes <input type="checkbox"/> No Size range of material 3.3mm		
Fine to coarse sand, clay streaks (loose)				From 0	To 130	11. Static water level: _____ mo./day/yr. 231 ft. below land surface Date 1-11-78
Fine to med. sand, clay streaks (loose)				130	200	12. Pumping level below land surfaces: 243 ft. after 1 hrs. pumping 1040 g.p.m. 263 ft. after 1 1/2 hrs. pumping 1669 g.p.m. Estimated maximum yield 2,000 g.p.m.
Tan clay				200	285	13. Water sample submitted: _____ mo./day/yr. Yes <input type="checkbox"/> No <input checked="" type="checkbox"/> Date _____
Fine to medium sand (loose)				285	302	14. Well head completion: _____ <input type="checkbox"/> Pitless adapter 12 inches above grade
Mixed colored clay				302	315	15. Well grouted? Yes With: <input type="checkbox"/> Neat cement <input checked="" type="checkbox"/> Bentonite <input type="checkbox"/> Concrete Depth: From 0 ft. to 10 ft.
Fine to medium sand (loose)				315	340	16. Nearest source of possible contamination: _____ ft. _____ Direction _____ Type Unknown Well disinfected upon completion? <input checked="" type="checkbox"/> Yes <input type="checkbox"/> No
Blue clay				340	360	17. Pump: _____ Not installed Manufacturer's name Layne & Bowler Model number 12 KL HP 96 Volts _____ Length of drop pipe 320 ft. capacity 800 g.p.m. Type: _____ <input type="checkbox"/> Submersible <input checked="" type="checkbox"/> Turbine <input type="checkbox"/> Jet <input type="checkbox"/> Reciprocating <input type="checkbox"/> Centrifugal <input type="checkbox"/> Other
Fine to medium sand, blue clay streaks Caliche streaks (loose)				360	395	
Mixed colored clay				395	455	
Fine to medium sand (little dirty)				455	475	
Mixed colored clay, sand streaks				475	490	
Fine sand, clay streaks (loose)				490	512	
Fine to medium sand (loose)				512	550	
Weathered shale				550	580	
Black shale				580	610	
(Use a second sheet if needed)				610	620	
18. Elevation:		19. Remarks:		20. Water well contractor's certification: This well was drilled under my jurisdiction and this report is true to the best of my knowledge and belief. Layne-Western Co. Inc. 102 Business name _____ License No. _____ Address Box 686 Garden City, Ks. Signed [Signature] Date 6 Feb 78 Authorized representative		
Topography: <input type="checkbox"/> Hill <input type="checkbox"/> Slope <input checked="" type="checkbox"/> Upland <input type="checkbox"/> Valley						

Forward the white, blue and pink copies to the Department of Health and Environment

Form WWC-5