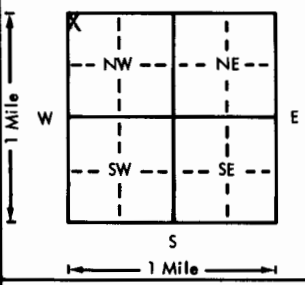


USE TYPEWRITER OR BALL
POINT PEN-PRESS FIRMLY,
PRINT CLEARLY.

WATER WELL RECORD
KSA 82a-1201-1215

Kansas Department of Health and
Environment-Division of Environment
(Water well Contractors)
Topeka, Kansas 66620

1. Location of well:	County Haskell	Fraction NW 1/4 NW 1/4 NW 1/4	Section number 31	Township number T 28 S	Range number R 31 E
2. Distance and direction from nearest town or city: 7N, 6E 1N of Sublette, Ks.			3. Owner of well: Lee Turner R.R. or street: 3900 Broadway City, state, zip code: Great Bend, Ks.		
4. Locate with "X" in section below: N W E S 1 Mile		Sketch map: 		6. Bore hole dia. 28 in. Completion date 5/7/77 Well depth 640 ft.	
5. Type and color of material		From To		7. ☒ Cable tool ☒ Rotary ☐ Driven ☐ Dug ☐ Hollow rod ☐ Jetted ☐ Bored ☐ Reverse rotary	
				8. Use: ☐ Domestic ☐ Public supply ☐ Industry ☒ Irrigation ☐ Air conditioning ☐ Stock ☐ Lawn ☐ Oil field water ☐ Other	
				9. Casing: Material STL Height: Above or below Threaded ☐ Welded ☒ Surface 12 in. RMP ☐ PVC ☐ Weight ☐ lbs./ft. Dia. 16 in. to 160 ft. depth Wall Thickness: inches or Dia. ☐ in. to ☐ ft. depth gage No. 249	
				10. Screen: Manufacturer's name Johnson Lakewood Pipe of Texas Type Screen & Mill Dia. 16" Slot/gauze 2508, 219 Length Screen 8 2 1/2 Set between 250, 460 ft. and 430, 640 ft. Sc. 240, 430 ft. and 250, 460 ft. Gravel pack? yes Size range of material 70% #1 Coarse 30% #2 Down	
				11. Static water level: 222 ft. below land surface Date 5/7/77 mo./day/yr.	
18. Elevation: Topography: ☐ Hill ☒ Slope ☒ Upland ☐ Valley		19. Remarks: 570-640 Coarse sand, gravel, clay streaks, Red Bed 640-660 570 660		12. Pumping level below land surfaces: 397 ft. after 3 hrs. pumping 1600 g.p.m. 1600 g.p.m. Estimated maximum yield 1600 g.p.m.	
				13. Water sample submitted: ☐ Yes ☒ No Date ☐	
				14. Well head completion: ☐ Pitless adapter 12 Inches above grade	
				15. Well grouted? yes With: ☐ Neat cement ☒ Bentonite ☐ Concrete Depth: From 0 ft. to 10 ft.	
				16. Nearest source of possible contamination: ft. NONE Direction ☐ Type ☐ Well disinfected upon completion? ☐ Yes ☒ No	
20. Water well contractor's certification: This well was drilled under my jurisdiction and this report is true to the best of my knowledge and belief. Clemens Irr. Drlg. 330 Business name P.O. Box 499 Liberal, Ks. License No. 1/4 NW 1/4 NW 1/4 Address 1/4 NW 1/4 NW 1/4 Signed Bill Clemens Date 5-10 Authorized representative		17. Pump: ☐ Not installed Manufacturer's name Goulds Model number 14JHC HP 200 Volts ☐ Length of drop pipe 460 ft. capacity 1600 p.m. Type: ☐ Submersible ☒ Turbine ☐ Jet ☐ Reciprocating ☐ Centrifugal ☐ Other			

Forward the white, blue and pink copies to the Department of Health and Environment

Form WWC-5