


WATER WELL RECORD Form WWC-5 KSA 82a-1212

1 LOCATION OF WATER WELL: Fraction Section Number Township Number Range Number  
 COUNTY: 041 HASKELL NE 1/4 NE 1/4 NE 1/4 32 T 28 S R 32 W

Distance and direction from nearest town or city street address of well if located within city?  
 APPROX. 1/2 MILE EAST & 6 MILES NORTH OF SUBLETTE

2 WATER WELL OWNER: GENEEN LOVE  
 RR#, St. Address, Box #: 1506 WILLOW LANE Board of Agriculture, Division of Water Resources  
 City, State, ZIP code: GARDEN CITY, KS 67846- Application Number: 16,972 23,408

3 LOCATE WELL'S LOCATION WITH AN "X" IN SECTION BOX: 4 DEPTH OF COMPLETED WELL 374 ELEVATION: 0  
 Depth(s) Groundwater Encountered 1. 0 ft. 2. 0 ft. 3. 0 ft.

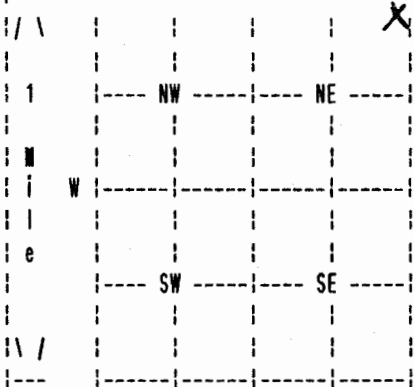

WELL'S STATIC WATER LEVEL 308 ft. below land surface measured on mo/day/yr 10/21/95  
 Pump test data: Well water was 0 ft. after 0 hours pumping 0 gpm  
 Estimated Yield 0 gpm: Well water was 0 ft. after 0 hours pumping 0 gpm  
 Bore Hole Diameter in. to 0 ft., and in. to 0 ft.  
 WELL WATER WAS: 02 IRRIGATION  
 Was a chemical/bacteriological sample submitted to department? No ;  
 If yes, mo/day/yr sample was submitted Water well disinfected? Yes

5 TYPE OF BLANK CASING USED: 01 STEEL CASING JOINTS: WELDED  
 Blank casing diameter 16 in. to 374 ft., Dia in. to 0 ft., Dia in. to 0 ft.  
 Casing height above land surface -48 in., weight 37 lbs/ft. Wall thickness or gauge No. .219  
 TYPE OF SCREEN OR PERFORATION MATERIAL: 01 STEEL  
 SCREEN OR PERFORATION OPENINGS ARE: 03 MILL SLOT

SCREEN PERFORATED INTERVALS: From 239 ft. to 439 ft., From 0 ft. to 0 ft.  
 From 0 ft. to 0 ft., From 0 ft. to 0 ft.  
 GRAVEL PACK INTERVALS: From 0 ft. to 0 ft., From 0 ft. to 0 ft.  
 From 0 ft. to 0 ft., From 0 ft. to 0 ft.

6 GROUT MATERIAL 02 CEMENT GROUT  
 Grout intervals: From 4 ft. to 16 ft., From 0 ft. to 0 ft., From 0 ft. to 0 ft.  
 What is the nearest source of possible contamination: IRRIGATION WELL  
 Direction from well? EAST How many feet? 110

FROM	TO	LITHOLOGIC LOG	FROM	TO	PLUGGING INTERVALS
			0	4	BACKFILL
			4	16	CEMENT GROUT
			16	260	CLAY
			260	374	SAND & GRAVEL
			0	0	
			0	0	
			0	0	
			0	0	
			0	0	
			0	0	

7 CONTRACTOR'S OR LANDOWNER'S CERTIFICATION: This water well was Plugged under my jurisdiction and was completed on (mo/day/year) 11/21/95 and this record is true to the best of my knowledge and belief. Kansas Water Well Contractor's License No. 145 This Water Well Record was completed on (mo/day/yr) 01/08/96 under the business name of HENKLE DRILLING & SUPPLY by (signature) Bruce J. Leckman