


WATER WELL RECORD Form WWC-5 KSA 82a-1212

1 LOCATION OF WATER WELL: | Fraction | Section Number | Township Number | Range Number
 COUNTY: 041 HASKELL | NE 1/4 NE 1/4 NE 1/4 | 32 | T 28 S | R 32 W

Distance and direction from nearest town or city street address of well, if located within city?
 APPROX. 1/2 MILE EAST AND 6 MILES NORTH OF SUBLETTE.

2 WATER WELL OWNER: LOVE, GENEEN
 RR#, St. Address, Box #: 1506 WILLOW LANE Board of Agriculture, Division of Water Resources
 City, State, ZIP code: GARDEN CITY, KS 67846- Application Number: 16,972 23,408

3 LOCATE WELL'S LOCATION WITH AN "X" IN SECTION BOX: | 4 DEPTH OF COMPLETED WELL 584 ELEVATION: 0
 Depth(s) Groundwater Encountered 1. 0 ft. 2. 0 ft. 3. 0 ft.

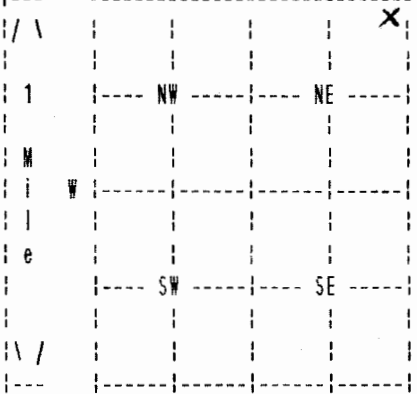

WELL'S STATIC WATER LEVEL 308 ft. below land surface measured on mo/day/yr 11/11/95
 Pump test data: Well water was 353 ft. after 4 hours pumping 1320 gpm
 Estimated Yield 1320 gpm: Well water was 0 ft. after 0 hours pumping 0 gpm
 Bore Hole Diameter 24 in. to 584 ft., and in. to 0 ft.
 WELL WATER TO BE USED AS: 02 IRRIGATION
 Was a chemical/bacteriological sample submitted to department? No ;
 If yes, mo/day/yr sample was submitted Water well disinfected? Yes

5 TYPE OF BLANK CASING USED: 01 STEEL CASING JOINTS: WELDED
 Blank casing diameter 16 in. to 584 ft., Dia in. to 0 ft., Dia in. to 0 ft.
 Casing height above land surface 12 in., weight 42 lbs/ft. Wall thickness or gauge No. .250
 TYPE OF SCREEN OR PERFORATION MATERIAL: 01 STEEL
 SCREEN OR PERFORATION OPENINGS ARE: 01 CONT. SLOT

SCREEN PERFORATED INTERVALS: From 340 ft. to 440 ft., From 0 ft. to 0 ft.
 From 481 ft. to 581 ft., From 0 ft. to 0 ft.
 GRAVEL PACK INTERVALS: From 20 ft. to 584 ft., From 0 ft. to 0 ft.
 From 0 ft. to 0 ft., From 0 ft. to 0 ft.

6 GROUT MATERIAL 03 BENTONITE
 Grout intervals: From 0 ft. to 0 ft., From 0 ft. to 0 ft., From 0 ft. to 0 ft.
 What is the nearest source of possible contamination: 14 ABAND. WELL
 Direction from well? WEST How many feet? 110

FROM	TO	LITHOLOGIC LOG	FROM	TO	PLUGGING INTERVALS
0	2	02 SILT			
2	52	01 CLAY 31 CALICHE			
52	75	07 FINE SAND 08 MEDIUM SAND 01 CLAY			
75	120	05 SAND 01 CLAY			
120	280	05 SAND 01 CLAY			
280	358	05 SAND 28 ROCK			
358	372	01 CLAY 20 LIMESTONE			
372	384	07 FINE SAND 08 MEDIUM SAND 09 COARSE SAND			
384	390	04 SANDY CLAY 05 SAND 20 LIMESTONE			
390	400	07 FINE SAND 08 MEDIUM SAND 09 COARSE SAND			

7 CONTRACTOR'S OR LANDOWNER'S CERTIFICATION: This water well was Constructed under my jurisdiction and was completed on (mo/day/year) 11/08/95 and this record is true to the best of my knowledge and belief. Kansas Water Well Contractor's License No. 145 This Water Well Record was completed on (mo/day/yr) 11/22/95 under the business name of HENKLE DRILLING & SUPPLY by (signature)

(Continued)

WATER WELL RECORD Form WWC-5 KSA 82a-1212

1 LOCATION OF WATER WELL: | Fraction | Section Number | Township Number | Range Number
COUNTY: 041 HASKELL | NE 1/4 NE 1/4 NE 1/4 | 32 | T 28 S | R 32 W

2 WATER WELL OWNER: LOVE, GENEEN
RR#, St. Address, Box #: 1506 WILLOW LANE Board of Agriculture, Division of Water Resources
City, State, ZIP code: GARDEN CITY, KS 67846- Application Number: 16,972 23,408

FROM	TO	LITHOLOGIC LOG
400	414	04 SANDY CLAY 07 FINE SAND 08 MEDIUM SAND
414	434	07 FINE SAND 08 MEDIUM SAND 09 COARSE SAND
434	481	04 SANDY CLAY 31 CALICHE 05 SAND
481	543	07 FINE SAND 08 MEDIUM SAND 04 SANDY CLAY
543	555	31 CALICHE 23 SANDSTONE
555	581	23 SANDSTONE 31 CALICHE
581	620	19 SHALE 23 SANDSTONE 20 LIMESTONE

7 CONTRACTOR'S OR LANDOWNER'S CERTIFICATION: This water well was Constructed under my jurisdiction and was completed on (mo/day/year) 11/08/95 and this record is true to the best of my knowledge and belief. Kansas Water Well Contractor's License No. 145 This Water Well Record was completed on (mo/day/yr) 11/22/95 under the business name of HENKLE DRILLING & SUPPLY

by (signature) *Bruce J. Reichmuth*