


## PLUGGING REPORT

Distance and direction from nearest town or city street address of well if located within city?

8 3/4 N of Sublette, KS

2	WATER WELL OWNER:	Berexco, Inc.	
	RR#, St. Address, Box # :	970 Fourth Financial Ctr.	Board of Agriculture, Division of Water Resources
	City, State, ZIP Code :	Wichita, KS 67202	Application Number: 900148

3 LOCATE WELL'S LOCATION WITH AN "X" IN SECTION BOX: 4 DEPTH OF COMPLETED WELL 480 ft. ELEVATION:

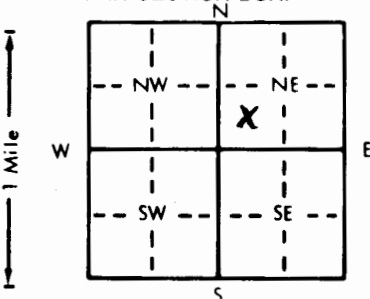

4] DEPTH OF COMPLETED WELL.....480..... ft. ELEVATION: .....  
 Depth(s) Groundwater Encountered 1..... ft. 2..... ft. 3..... ft.  
 WELL'S STATIC WATER LEVEL ....270.... ft. below land surface measured on mo/day/yr ....09-18-90  
 Pump test data: Well water was ..... ft. after ..... hours pumping ..... gpm  
 Est. Yield ..... gpm: Well water was ..... ft. after ..... hours pumping ..... gpm  
 Bore Hole Diameter ..... in. to ..... ft., and ..... in. to ..... ft.  
 WELL WATER TO BE USED AS:  
     1 Domestic      3 Feedlot      ⑥ Oil field water supply      9 Dewatering      11 Injection well  
     2 Irrigation     4 Industrial      7 Lawn and garden only      12 Other (Specify below)  
 Was a chemical/bacteriological sample submitted to Department? Yes.....No.....; If yes, mo/day/yr sample was submitted  
    Water Well Disinfected? Yes.....No.....

5 TYPE OF BLANK CASING USED:		5 Wrought iron	8 Concrete tile	CASING JOINTS: Glued . . . . . Clamped . . . . .	
1 Steel	3 RMP (SR)	6 Asbestos-Cement	9 Other (specify below)	Welded . . . . .	
2 PVC	4 ABS	7 Fiberglass		Threaded . . . . .	
Blank casing diameter . . . . . 6 . . . in. to . . . ft. Dia . . . . .		. . . in. to . . . ft. Dia . . . . .		. . . in. to . . . ft. Dia . . . . .	

Casing height above land surface... **6'** below ..... in., weight ..... lbs./ft. Wall thickness or gauge No. ....

TYPE OF SCREEN OR PERFORATION MATERIAL:

1 Steel	3 Stainless steel	5 Fiberglass	7 PVC	10 Asbestos-cement
2 Brass	4 Galvanized steel	6 Concrete tile	8 RMP (SR)	11 Other (specify) .....
			9 ABS	12 None used (open hole)

SCREEN OR PERFORATION OPENINGS ARE:

1 Continuous slot	3 Mill slot	5 Gauzed wrapped	8 Saw cut	11 None (open hole)
2 Louvered shutter	4 Key punched	6 Wire wrapped	9 Drilled holes	
		7 Torch cut	10 Other (specify) .....	

SCREEN-PERFORATED INTERVALS:	From . . . . . ft. to . . . . . ft.,	From . . . . . ft. to . . . . . ft.
	From . . . . . ft. to . . . . . ft.,	From . . . . . ft. to . . . . . ft.
GRAVEL PACK INTERVALS:	From . . . . . ft. to . . . . . ft.,	From . . . . . ft. to . . . . . ft.
	From . . . . . ft. to . . . . . ft.,	From . . . . . ft. to . . . . . ft.

6 GROUT MATERIAL: 1 Neat cement 2 Cement grout 3 Bentonite 4 Other

Grout intervals: From 10 ft. to 6 ft., From ft. to ft., From ft. to ft.

What is the nearest source of possible contamination:

1 Septic tank	4 Lateral lines	7 Pit privy	10 Livestock pens	14 Abandoned water well
2 Sewer lines	5 Cess pool	8 Sewage lagoon	11 Fuel storage	15 Oil well/Gas well
3 Watertight sewer lines	6 Seepage pit	9 Feedyard	12 Fertilizer storage	16 Other (specify below)

Direction from well? Northwest

How many feet? 150

[illegible]

7] CONTRACTOR'S OR LANDOWNER'S CERTIFICATION: This water well was (1) constructed, (2) reconstructed, or (3) plugged under my jurisdiction and was completed on (mo/day/year) 09-18-90 and this record is true to the best of my knowledge and belief. Kansas Water Well Contractor's License No. KWWCL-430 This Water Well Record was completed on (mo/day/yr) 09-18-90 under the business name of Howard Drlg. Co. Box 806 Beaver, OK 73932 by (signature)

INSTRUCTIONS: Use typewriter or ball point pen. PLEASE PRESS FIRMLY and PRINT clearly. Please fill in blanks, underline or circle the correct answers. Send top three copies to Kansas Department of Health and Environment, Bureau of Water, Topeka, Kansas 66620-7320. Telephone: 913-296-5545. Send one to WATER WELL OWNER and retain one for your records.

#11906/11106