


1 LOCATION OF WATER WELL: County: <b>Haskell</b>	Fraction <b>NW 1/4 NW 1/4 NW 1/4</b>	Section Number <b>32</b>	Township Number <b>T 28 S</b>	Range Number <b>R 32 EW</b>
---	---	-----------------------------	----------------------------------	--------------------------------

Distance and direction from nearest town or city street address of well if located within city?  
**9 miles North of Sublette 1 1/2 East and South into**

2 WATER WELL OWNER: RR#, St. Address, Box # : City, State, ZIP Code :	<b>Droll A Gabbert &amp; Jones</b> <b>333 E. English #215</b> <b>Wichita, KS 67202</b>	Board of Agriculture, Division of Water Resources Application Number: <b>900078</b>
---	--	--

3 LOCATE WELL'S LOCATION WITH AN "X" IN SECTION BOX:

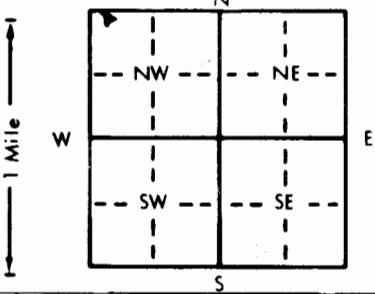

4 DEPTH OF COMPLETED WELL: <b>480</b> ft. ELEVATION:	Depth(s) Groundwater Encountered 1. _____ ft. 2. _____ ft. 3. _____ ft.
WELL'S STATIC WATER LEVEL: <b>320</b> ft. below land surface measured on mo/day/yr <b>2-28-90</b>	Pump test data: Well water was _____ ft. after _____ hours pumping _____ gpm
Est. Yield _____ gpm: Well water was _____ ft. after _____ hours pumping _____ gpm	Bore Hole Diameter _____ in. to _____ ft., and _____ in. to _____ ft.
WELL WATER TO BE USED AS:	5 Public water supply 8 Air conditioning 11 Injection well
1 Domestic 3 Feedlot 6 Oil field water supply 9 Dewatering 12 Other (Specify below)	2 Irrigation 4 Industrial 7 Lawn and garden only 10 Monitoring well
Was a chemical/bacteriological sample submitted to Department? Yes _____ No _____; If yes, mo/day/yr sample was submitted	Water Well Disinfected? Yes _____ No _____

5 TYPE OF BLANK CASING USED:	5 Wrought iron 8 Concrete tile CASING JOINTS: Glued _____ Clamped _____
1 Steel 3 RMP (SR) 6 Asbestos-Cement 9 Other (specify below) Welded _____	2 PVC 4 ABS 7 Fiberglass Threaded _____
Blank casing diameter _____ 5 _____ in. to _____ 380 _____ ft., Dia _____ in. to _____ ft., Dia _____ in. to _____ ft.	Casing height above land surface _____ in., weight _____ lbs./ft. Wall thickness or gauge No. _____

TYPE OF SCREEN OR PERFORATION MATERIAL:	7 PVC 10 Asbestos-cement
1 Steel 3 Stainless steel 5 Fiberglass 8 RMP (SR) 11 Other (specify) _____	2 Brass 4 Galvanized steel 6 Concrete tile 9 ABS 12 None used (open hole)
SCREEN OR PERFORATION OPENINGS ARE:	5 Gauzed wrapped 8 Saw cut 11 None (open hole)
1 Continuous slot 3 Mill slot 6 Wire wrapped 9 Drilled holes	2 Louvered shutter 4 Key punched 7 Torch cut 10 Other (specify) _____
SCREEN-PERFORATED INTERVALS: From _____ 380 _____ ft. to _____ 480 _____ ft., From _____ ft. to _____ ft.	GRAVEL PACK INTERVALS: From _____ ft. to _____ ft., From _____ ft. to _____ ft.

6 GROUT MATERIAL:	1 Neat cement 2 Cement grout 3 Bentonite 4 Other _____
Grout intervals: From _____ ft. to _____ ft., From _____ ft. to _____ ft., From _____ ft. to _____ ft.	What is the nearest source of possible contamination:
1 Septic tank 4 Lateral lines 7 Pit privy 10 Livestock pens 14 Abandoned water well	2 Sewer lines 5 Cess pool 8 Sewage lagoon 11 Fuel storage 15 Oil well/Gas well
3 Watertight sewer lines 6 Seepage pit 9 Feedyard 12 Fertilizer storage 16 Other (specify below) _____	13 Insecticide storage _____
Direction from well? <b>Southwest</b>	How many feet? <b>300</b>

FROM	TO	LITHOLOGIC LOG	FROM	TO	PLUGGING INTERVALS
			<b>480</b>	<b>310</b>	<b>Sand</b>
			<b>310</b>	<b>290</b>	<b>Cement and hole plug</b>
			<b>290</b>	<b>23</b>	<b>Sand</b>
			<b>23</b>	<b>3</b>	<b>Cement and hole plug</b>
			<b>3</b>	<b>0</b>	<b>Topsoil</b>

7 CONTRACTOR'S OR LANDOWNER'S CERTIFICATION: This water well was (1) constructed, (2) reconstructed, or (3) plugged under my jurisdiction and was completed on (mo/day/year) **4-6-90** and this record is true to the best of my knowledge and belief. Kansas Water Well Contractor's License No. **142**. This Water Well Record was completed on (mo/day/yr) **4-10-90** under the business name of **T & W Water Well Service, Inc.** by (signature) *[Signature]*

INSTRUCTIONS: Use typewriter or ball point pen. PLEASE PRESS FIRMLY and PRINT clearly. Please fill in blanks, underline or circle the correct answers. Send top three copies to Kansas Department of Health and Environment, Bureau of Water, Topeka, Kansas 66620-7320. Telephone: 913-296-5545. Send one to WATER WELL OWNER and retain one for your records.

OFFICE USE ONLY  
T  
R  
EW  
SEC.