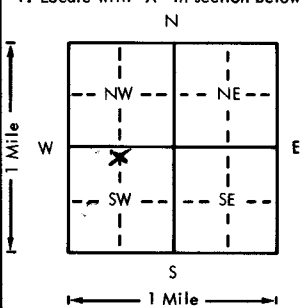


USE TYPEWRITER OR BALL  
POINT PEN-PRESS FIRMLY,  
PRINT CLEARLY.

WATER WELL RECORD  
KSA 82a-1201-1215

Kansas Department of Health and  
Environment-Division of Environment  
(Water well Contractors)  
Topeka, Kansas 66620

1. Location of well:	County <b>Haskell</b>	Fraction <b>N/2 1/4 N 1/2 1/4 SW 1/4</b>	Section number <b>11</b>	Township number <b>T 28 S</b>	Range number <b>R 33 E</b>
2. Distance and direction from nearest town or city: <b>9 1/2 N. &amp; 3 1/2 W. of Sublette</b> Street address of well location if in city:			3. Owner of well: <b>Forrest Cox</b> R.R. or street: City, state, zip code: <b>Sublette, KS 67877</b>		
4. Locate with "X" in section below: 			Sketch map:		
5. Type and color of material <b>See attachment</b>			From	To	6. Bore hole dia. <b>26</b> in. Completion date <b>11-1-76</b> Well depth <b>458</b> ft.
					7. <input type="checkbox"/> Cable tool <input type="checkbox"/> Rotary <input type="checkbox"/> Driven <input type="checkbox"/> Dug <input type="checkbox"/> Hollow rod <input type="checkbox"/> Jetted <input type="checkbox"/> Bored <input checked="" type="checkbox"/> Reverse rotary
					8. Use: <input type="checkbox"/> Domestic <input type="checkbox"/> Public supply <input type="checkbox"/> Industry <input checked="" type="checkbox"/> Irrigation <input type="checkbox"/> Air conditioning <input type="checkbox"/> Stock <input type="checkbox"/> Lawn <input type="checkbox"/> Oil field water <input type="checkbox"/> Other
					9. Casing: Material <b>Steel</b> Height: <b>Above</b> or below Threaded <input type="checkbox"/> Welded <input checked="" type="checkbox"/> Surface <b>12</b> in. RMP <input type="checkbox"/> PVC <input type="checkbox"/> Weight <b>36</b> lbs./ft. Dia. <b>16</b> in. to <b>458</b> ft. depth Wall Thickness: inches or Dia. <input type="checkbox"/> in. to <input type="checkbox"/> ft. depth gage No. <b>219</b>
					10. Screen: Manufacturer's name <b>Brown</b> Type <b>Louvered</b> Dia. <b>16"</b> Slot/gauze <b>1/8"</b> Length <b>75'</b> Set between <b>455</b> ft. and <b>380</b> ft. Gravel pack? <b>Yes</b> Size range of material <b>1/4 x 1/8</b>
					11. Static water level: <b>288</b> ft. below land surface Date <b>11-3-76</b>
					12. Pumping level below land surfaces: <b>314</b> ft. after <input type="checkbox"/> hrs. pumping <b>1451</b> g.p.m. <input type="checkbox"/> ft. after <input type="checkbox"/> hrs. pumping <input type="checkbox"/> g.p.m. Estimated maximum yield <input type="checkbox"/> g.p.m.
					13. Water sample submitted: <input type="checkbox"/> Yes <input checked="" type="checkbox"/> No Date <input type="checkbox"/>
					14. Well head completion: <input type="checkbox"/> Pitless adapter <b>12</b> Inches above grade
					15. Well grouted? <b>Yes</b> With: <input type="checkbox"/> Neat cement <input checked="" type="checkbox"/> Bentonite <input type="checkbox"/> Concrete Depth: From <b>0</b> ft. to <b>10</b> ft.
					16. Nearest source of possible contamination: <b>None</b> ft. <input type="checkbox"/> Direction <input type="checkbox"/> Type <b>observed</b> Well disinfected upon completion? <input type="checkbox"/> Yes <input checked="" type="checkbox"/> No
					17. Pump: <input checked="" type="checkbox"/> Not installed Manufacturer's name <input type="checkbox"/> Model number <input type="checkbox"/> HP <input type="checkbox"/> Volts <input type="checkbox"/> Length of drop pipe <input type="checkbox"/> ft. capacity <input type="checkbox"/> g.p.m. Type: <input type="checkbox"/> Submersible <input type="checkbox"/> Turbine <input type="checkbox"/> Jet <input type="checkbox"/> Reciprocating <input type="checkbox"/> Centrifugal <input type="checkbox"/> Other
					20. Water well contractor's certification: This well was drilled under my jurisdiction and this report is true to the best of my knowledge and belief. <b>Henkle Drlg. &amp; Supply 145</b> Business name <b>Box 639, Garden City, KS</b> Address <b>E. L. Bethune</b> Signed <b>E. L. Bethune</b> Date <b>11-9-76</b> Authorized representative
18. Elevation: <b>Flat</b> Topography: <input type="checkbox"/> Hill <input type="checkbox"/> Slope <input type="checkbox"/> Upland <input type="checkbox"/> Valley	19. Remarks:  (Use a second sheet if needed)				

Forward the white, blue and pink copies to the Department of Health and Environment

Form WWC-5

# DRILLERS TEST LOG

CUSTOMERS NAME Forrest Cox DATE 7-20-76  
STREET ADDRESS \_\_\_\_\_ TEST # 1  
CITY & STATE Sublette, KS DRILLER Martinez  
COUNTY Haskell QUARTER SW SECTION 11 TOWNSHIP 28 RANGE 33

LOCATION 1400' E. of the N.W. corner of the S.W.  $\frac{1}{4}$

[illegible]

RDEN CITY, KANSAS      HENKLE DRILLING & SUPPLY CO., INC.      SUBLETTE, KANSAS  
ONE 276-3278      IRRIGATION HEADQUARTERS      PHONE 675-4311

ST HOLES\*\*\*\*\*STOCK WELLS\*\*\*\*\*IRRIGATION AND INDUSTRIAL WELLS\*\*\*\*\*