WATER WELL RECORD Form WWC-5 KSA 82a-1212

1 LOCATION OF WATER WELL: County: Haskell | Fraction: ¼ ¼ SW ¼ | Section Number: 25 | Township Number: T 28 S | Range Number: R 33 E W

Distance and direction from nearest town or city street address of well if located within city? From Sublette 8 North ON Hiway 83 - 1 West

2 WATER WELL OWNER: Kent Messerly
RR#, St. Address, Box # : Rural Route
City, State, ZIP Code : Sublette, KS 67877
Board of Agriculture, Division of Water Resources Application Number:

3 LOCATE WELL'S LOCATION WITH AN "X" IN SECTION BOX:

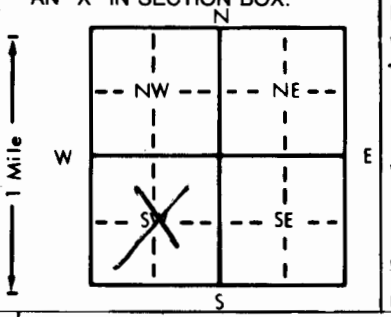

4 DEPTH OF COMPLETED WELL 440 ft. ELEVATION:
Depth(s) Groundwater Encountered 1. ft. 2. ft. 3. ft.
WELL'S STATIC WATER LEVEL 306 ft. below land surface measured on mo/day/yr
None Pump test data: Well water was ft. after hours pumping gpm
Est. Yield gpm: Well water was ft. after hours pumping gpm
Bore Hole Diameter 10 5/8 in. to 440 ft., and in. to ft.
WELL WATER TO BE USED AS: 1 Domestic 3 Feedlot 5 Public water supply 6 Oil field water supply 8 Air conditioning 9 Dewatering 11 Injection well 12 Other (Specify below)
2 Irrigation 4 Industrial 7 Lawn and garden only 10 Observation well
Was a chemical/bacteriological sample submitted to Department? Yes No X; If yes, mo/day/yr sample was submitted Water Well Disinfected? Yes No X

5 TYPE OF BLANK CASING USED: 1 Steel 2 PVC 3 RMP (SR) 4 ABS 5 Wrought iron 6 Asbestos-Cement 7 Fiberglass 8 Concrete tile 9 Other (specify below)
CASING JOINTS: Glued Clamped Welded X Threaded
Blank casing diameter 6 5/8 in. to 401 ft., Dia in. to ft., Dia in. to ft.
Casing height above land surface 12 in., weight 12.8 lbs./ft. Wall thickness or gauge No. .188

TYPE OF SCREEN OR PERFORATION MATERIAL: 1 Steel 2 Brass 3 Stainless steel 4 Galvanized steel 5 Fiberglass 6 Concrete tile 7 PVC 8 RMP (SR) 9 ABS 10 Asbestos-cement 11 Other (specify) 12 None used (open hole)

SCREEN OR PERFORATION OPENINGS ARE: 1 Continuous slot 2 Louvered shutter 3 Mill slot 4 Key punched 5 Gauzed wrapped 6 Wire wrapped 7 Torch cut 8 Saw cut 9 Drilled holes 10 Other (specify) 11 None (open hole)

SCREEN-PERFORATED INTERVALS: From 401 ft. to 441 ft., From ft. to ft.
From ft. to ft., From ft. to ft.
GRAVEL PACK INTERVALS: From 10 ft. to 440 ft., From ft. to ft.
From ft. to ft., From ft. to ft.

6 GROUT MATERIAL: 1 Neat cement 2 Cement grout 3 Bentonite 4 Other
Grout Intervals: From 0 ft. to 10 ft., From ft. to ft., From ft. to ft.

What is the nearest source of possible contamination:
1 Septic tank 2 Sewer lines 3 Watertight sewer lines 4 Lateral lines 5 Cess pool 6 Seepage pit 7 Pit privy 8 Sewage lagoon 9 Feedyard 10 Livestock pens 11 Fuel storage 12 Fertilizer storage 13 Insecticide storage 14 Abandoned water well 15 Oil well/Gas well 16 Other (specify below) N/A
Direction from well? How many feet?

FROM	TO	LITHOLOGIC LOG	FROM	TO	LITHOLOGIC LOG
		Test log attached			

7 CONTRACTOR'S OR LANDOWNER'S CERTIFICATION: This water well was (1) constructed, (2) reconstructed, or (3) plugged under my jurisdiction and was completed on (mo/day/year) July 16, 1982 and this record is true to the best of my knowledge and belief. Kansas Water Well Contractor's License No. 208 This Water Well Record was completed on (mo/day/yr) September 1, 1982 under the business name of Minter Wilson Drilling Co., Inc. by (signature) Irene DeLeyser

INSTRUCTIONS: Use typewriter or ball point pen, *PLEASE PRESS FIRMLY* and *PRINT* clearly. Please fill in blanks, underline or circle the correct answers. Send top three copies to Kansas Department of Health and Environment, Division of Environment, Environmental Geology Section, Topeka, KS 66620. Send one to WATER WELL OWNER and retain one for your records.

OFFICE USE ONLY T 28 R 33 E W SEC. 25 SW ¼ ¼ ¼

The Professionals
MINTER-WILSON DRILLING CO.
INCORPORATED
Irrigation and Domestic Water Systems
Complete Installation and Repairing

Phone 276-8269 • P.O. Box A • GARDEN CITY, KANSAS 67846

KENT MESSERLY
Haskell County
July 6, 1982

Location:
Static Water Level:
Test #

0	1	Top Soil
1	63	Brown Clay
63	120	Fine to Medium Sand & Gravel (Loose)
120	180	Medium to Coarse Gravel (Loose)
180	212	Brown Clay
212	280	Fine to Medium Sand & Gravel (Loose)
280	312	Fine to Medium Sand & Gravel 30% Clay
312	365	Fine to Medium Sand & Gravel 10% Clay (Loose)
365	380	Fine to Medium Sand & Gravel 40% Clay
380	402	Brown Clay & White Rock 30% Clay (Tight)
402	421	Fine to Medium Sand & Gravel 10% Clay (Loose)
421	440	Fine to Medium Sand & Gravel 35% Clay (Tight)
440	452	Brown Clay 30% Gravel (Tight)
452	470	Brown Clay 20% Gravel (Tight)
470	490	Brown & White Clay (Tight)
490	500	Gray Brown & Yellow Clay (Hard)

Drilled big hole 440'
6 5/8 Casing 400' Plain
40' Perf