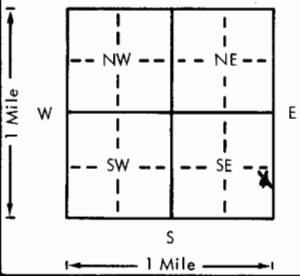


USE TYPEWRITER OR BALL
POINT PEN - PRESS FIRMLY,
PRINT CLEARLY.

WATER WELL RECORD
KSA 82a-1201-1215

Kansas Department of Health and
Environment - Division of Environment
(Water well Contractors)
Topeka, Kansas 66620

1. Location of well:		County Haskell	Fraction NE 1/4 SE 1/4 SE 1/4	Section number 20	Township number T 28 S R 33 E/W	Range number
2. Distance and direction from nearest town or city: Approximately 7 1/2 miles NW of Sublette, Kansas. Street address of well location if in city:				3. Owner of well: R. F. Lee R.R. or street: 400 N. Inman City, state, zip code: Sublette, Kansas 67877		
4. Locate with "X" in section below: 			Sketch map:			
5. Type and color of material			From	To	6. Bore hole dia. 26 in. Completion date 9/18/78 Well depth 545 ft.	
see Attachment					7. <input type="checkbox"/> Cable tool <input type="checkbox"/> Rotary <input type="checkbox"/> Driven <input type="checkbox"/> Dug <input type="checkbox"/> Hollow rod <input type="checkbox"/> Jetted <input type="checkbox"/> Bored <input checked="" type="checkbox"/> Reverse rotary	
					8. Use: <input type="checkbox"/> Domestic <input type="checkbox"/> Public supply <input type="checkbox"/> Industry <input checked="" type="checkbox"/> Irrigation <input type="checkbox"/> Air conditioning <input type="checkbox"/> Stock <input type="checkbox"/> Lawn <input type="checkbox"/> Oil field water <input type="checkbox"/> Other	
					9. Casing: Material Steel Height: Above or below Threaded <input type="checkbox"/> Welded <input checked="" type="checkbox"/> Surface 12 in. RMP <input type="checkbox"/> PVC <input type="checkbox"/> Weight 42.05 lbs./ft. Dia. 16 in. to 545 ft. depth Wall Thickness: inches or Dia. <input type="checkbox"/> in. to <input type="checkbox"/> ft. depth gage No. .250	
					10. Screen: Manufacturer's name Johnson Screen Type Continuous Dia. 16" Slot/gauze .100 Length 40' Set between 305 ft. and 325 ft. 345'-360' ft. and 380'-385' ft. Gravel pack? Yes Size range of material #1 Coarse & #2 Down	
					11. Static water level: 303 ft. below land surface Date 9/20/78	
					12. Pumping level below land surfaces: 355 ft. after <input type="checkbox"/> hrs. pumping 1217 g.p.m. <input type="checkbox"/> ft. after <input type="checkbox"/> hrs. pumping <input type="checkbox"/> g.p.m. Estimated maximum yield 1,200 g.p.m.	
					13. Water sample submitted: <input type="checkbox"/> Yes <input checked="" type="checkbox"/> No Date <input type="checkbox"/>	
					14. Well head completion: <input type="checkbox"/> Pitless adapter 12 inches above grade	
					15. Well grouted? Yes With: <input type="checkbox"/> Neat cement <input checked="" type="checkbox"/> Bentonite <input type="checkbox"/> Concrete Depth: From 0 ft. to 10 ft.	
					16. Nearest source of possible contamination: None Observed ft. <input type="checkbox"/> Direction <input type="checkbox"/> Type <input type="checkbox"/> Well disinfected upon completion? <input type="checkbox"/> Yes <input checked="" type="checkbox"/> No	
					17. Pump: <input checked="" type="checkbox"/> Not installed Manufacturer's name <input type="checkbox"/> Model number <input type="checkbox"/> HP <input type="checkbox"/> Volts <input type="checkbox"/> Length of drop pipe <input type="checkbox"/> ft. capacity <input type="checkbox"/> g.p.m. Type: <input type="checkbox"/> Submersible <input type="checkbox"/> Turbine <input type="checkbox"/> Jet <input type="checkbox"/> Reciprocating <input type="checkbox"/> Centrifugal <input type="checkbox"/> Other	
(Use a second sheet if needed)						
18. Elevation: x Flat Topography: <input type="checkbox"/> Hill <input type="checkbox"/> Slope <input type="checkbox"/> Upland <input type="checkbox"/> Valley		19. Remarks:		20. Water well contractor's certification: This well was drilled under my jurisdiction and this report is true to the best of my knowledge and belief. Henkle Drilling & Sply 145 Business name License No. Address Box 639, Garden City, KS Signed Bruce R. Henkle Date 9/26/78 Authorized representative		

Forward the white, blue and pink copies to the Department of Health and Environment

Form WWC-5

DRILLERS TEST LOG

CUSTOMERS NAME R. F. Lee DATE 12/12/77
STREET ADDRESS _____ TEST # #3 E. LOG Yes
CITY & STATE Sublette, Kansas DRILLER Martinez
COUNTY Haskell QUARTER SE SECTION 20 TOWNSHIP 28 RANGE 33
LOCATION 150' East of Test Hole #1

				WELL LOCATION	
%	FOOTAGE			DESCRIPTION OF STRATA	Static Water Level _____ Proposed Well Depth _____
	From	Pay	To		
	0		2	Top Soil	
	2		59	Brown clay	
	59		178	Sand fine to med coarse with small to large gravel.	
	178		200	Brown clay - sticky.	
	200		280	Blue clay - sticky.	
50	280	10	300	Sand fine to med coarse. Loose - used water.	
60	300	23	323	Sand fine to med coarse. Small gravel. Loose - used used water.	
	323		346	Brown and blue clay - sticky.	
60	346	14	360	Sand fine to med coarse, small gravel. Loose - used water.	
	360		372	Brown clay - sticky.	
45	372	08	380	Sand fine to med with a few coarse. Loose - used water.	
60	380	15	395	Sand fine to med coarse, small gravel. Loose - used water.	
	395		408	Brown clay	
60	408	09	417	Sand fine to med coarse, a few small gravel. Loose - used water.	
	417		421	Brown clay	
50	421	17	438	Sand fine to med coarse. Loose - used water.	
	438		444	Brown clay	
50	444	11	455	Sand fine to med coarse. Loose - used water. Had a few cemented sts.	
	455		480	Brown clay with a few limerock sts.	
25	480	16	496	Fine sand with limerock sts. Loose - used water.	
	496		530	Brown clay with a few limerock sts.	
65	530	11	541	Sand fine to med coarse, small brown gravel. Loose used water.	
	541		563	Yellow clay and soapstone.	
	563		580	Weather shale	
		134			
				TOTAL DEPTH OF WELL 550'	
				Set up facing East	
				Dig pit on the South	
				Used 2 QUIK GEL	

GARDEN CITY, KS
Phone 276-3278

HENKLE DRILLING & SUPPLY CO., INC.
IRRIGATION HEADQUARTERS

SUBLETTE, KS
Phone 675-4311

TEST HOLES * * * * * IRRIGATION & INDUSTRIAL WELLS * * * * STOCK WELLS