

USE TYPEWRITER OR BALL  
POINT PEN-PRESS FIRMLY,  
PRINT CLEARLY.

WATER WELL RECORD  
KSA 82a-1201-1215

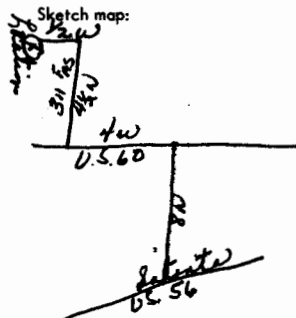
Kansas Department of Health and  
Environment-Division of Environment  
(Water well Contractors)  
Topeka, Kansas 66620

Dubois 1-A

CWW Inv. # 12643

1. Location of well:	County <u>Haskell</u>	Fraction <u>1/4 NE 1/4 SW 1/4</u>	Section number <u>8</u>	Township number <u>T 28 S</u>	Range number <u>R 34 E/W</u>
----------------------	-----------------------	-----------------------------------	-------------------------	-------------------------------	------------------------------

2. Distance and direction from nearest town or city: 8 miles north of Satanta, 4 west, 4 1/2 north, 1/2 west to loc.  
Street address of well location if in city:  
3. Owner of well: Gabbert & Jones, Inc. Rig #11  
R.R. or street: 830 Sutton Place  
City, state, zip code: Wichita, Kansas 67202

4. Locate with "X" in section below: N W E S 1 Mile 1 Mile	Sketch map: 	6. Bore hole dia. <u>9</u> in. Completion date <u>8-30</u> Well depth <u>480</u> ft.
--	--	---

5. Type and color of material	From	To	6. Bore hole dia. <u>9</u> in. Completion date <u>8-30</u> Well depth <u>480</u> ft.
Surface	0	2	7. <u>X</u> Cable tool <u>X</u> Rotary <u>  </u> Driven <u>  </u> Dug <u>  </u> <u>  </u> Hollow rod <u>  </u> Jetted <u>  </u> Bored <u>  </u> Reverse rotary
Sandy clay	2	60	8. Use: <u>  </u> Domestic <u>  </u> Public supply <u>  </u> Industry <u>  </u> <u>  </u> Irrigation <u>  </u> Air conditioning <u>  </u> Stock <u>  </u> <u>  </u> Lawn <u>X</u> Oil field water <u>  </u> Other
Fine sand and sandy clay 70-30	60	80	9. Casing: Material <u>  </u> Height: Above or below <u>  </u> Threaded <u>  </u> Welded <u>  </u> Surface <u>28</u> in. RMP <u>  </u> PVC <u>X</u> Weight <u>2.78</u> lbs./ft. Dia. <u>5</u> in. to <u>270</u> ft. depth Wall Thickness: inches or <u>  </u> Dia. <u>5</u> in. to <u>480</u> ft. depth gauge No. <u>265</u>
Medium to large sand	80	210	10. Screen: Manufacturer's name <u>  </u> <u>sawed perf.</u>
Med. to large sand & sandy clay 30-70	210	360	Type <u>PVC</u> Dia. <u>5</u> in. Slot/gauze <u>.030</u> Length <u>200</u> Set between <u>270</u> ft. and <u>470</u> ft. <u>  </u> ft. and <u>  </u> ft.
Med. to large sand & sandy clay 40-60	360	400	Gravel pack? <u>yes</u> Size range of material <u>1/8 to 3/16</u>
Med. to large sand & sandy clay 60-40	400	470	11. Static water level: <u>250</u> ft. below land surface Date <u>8-30-76</u> mo./day/yr.
Sandy clay	470	480	12. Pumping level below land surfaces: <u>  </u> ft. after <u>  </u> hrs. pumping <u>  </u> g.p.m. <u>  </u> ft. after <u>  </u> hrs. pumping <u>  </u> g.p.m. Estimated maximum yield <u>30</u> g.p.m.
			13. Water sample submitted: <u>  </u> mo./day/yr. Yes <u>X</u> No <u>  </u> Date <u>  </u>
			14. Well head completion: <u>  </u> Pitless adapter <u>28</u> inches above grade
			15. Well grouted? <u>yes</u> With: <u>X</u> Neat cement <u>  </u> Bentonite <u>  </u> Concrete <u>  </u> Depth: From <u>0</u> ft. to <u>10</u> ft.
			16. Nearest source of possible contamination: ft. <u>100</u> Direction <u>NE</u> Type <u>oil well</u> Well disinfected upon completion? <u>X</u> Yes <u>  </u> No <u>  </u>
			17. Pump: <u>X</u> Not installed Manufacturer's name <u>  </u> Model number <u>  </u> HP <u>  </u> Volts <u>  </u> Length of drop pipe <u>  </u> ft. capacity <u>  </u> g.p.m. Type: <u>  </u> Submersible <u>  </u> Turbine <u>  </u> <u>  </u> Jet <u>  </u> Reciprocating <u>  </u> <u>  </u> Centrifugal <u>  </u> Other <u>  </u>

18. Elevation:	19. Remarks:	20. Water well contractor's certification: This well was drilled under my jurisdiction and this report is true to the best of my knowledge and belief. <u>Carlile Water Well 118</u> Business name <u>Box 275, Liberal, KS</u> License No. <u>  </u> Address <u>  </u> Signed <u>Edward E. Means</u> Date <u>9-10</u> Authorized representative
----------------	--------------	---

Forward the white, blue and pink copies to the Department of Health and Environment

Form WWC-5