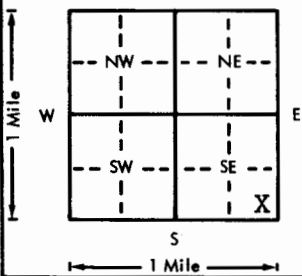


USE TYPEWRITER OR BALL
POINT PEN-PRESS FIRMLY,
PRINT CLEARLY.

WATER WELL RECORD
KSA 82a-1201-1215

Kansas Department of Health and
Environment-Division of Environment
(Water well Contractors)
Topeka, Kansas 66620

1. Location of well:	County Haskell	Fraction SE 1/4 SE 1/4 SE 1/4	Section number 21	Township number T 28 S R 34	Range number 34	X/W
2. Distance and direction from nearest town or city: 10 1/2 N., 3 W. of Satanta, Ks. Street address of well location if in city:			3. Owner of well: Wesley XXXX Lucas R.R. or street: Satanta, Kansas 67870 City, state, zip code:			
4. Locate with "X" in section below: N 1 Mile W E S 1 Mile			Sketch map: 			
5. Type and color of material			From	To	6. Bore hole dia. 9 7/8 in. Completion date 8-10-76 Well depth 445 ft.	
Top soil			0	5	7. Cable tool <input checked="" type="checkbox"/> Rotary <input type="checkbox"/> Driven <input type="checkbox"/> Dug <input type="checkbox"/> Hollow rod <input type="checkbox"/> Jetted <input type="checkbox"/> Bored <input type="checkbox"/> Reverse rotary	
Clay			6	50	8. Use: <input checked="" type="checkbox"/> Domestic <input type="checkbox"/> Public supply <input type="checkbox"/> Industry <input type="checkbox"/> Irrigation <input type="checkbox"/> Air conditioning <input type="checkbox"/> Stock <input type="checkbox"/> Lawn <input type="checkbox"/> Oil field water <input type="checkbox"/> Other	
Fine sand			51	95	9. Casing: Material PVC Height: Above or below Threaded <input type="checkbox"/> Welded <input checked="" type="checkbox"/> Surface 12 in. RMP <input type="checkbox"/> PVC <input type="checkbox"/> Weight <input type="checkbox"/> lbs./ft. Dia. 5 in. to 445 ft. depth Wall Thickness: inches or Dia. <input type="checkbox"/> in. to <input type="checkbox"/> ft. depth gage No. 265	
Med. sand			96	125	10. Screen: Manufacturer's name Jess & Lowell Type PVC Dia. 5" Slot/gauze 1/8" Length 100' Set between 345 ft. and 445 ft. ft. and <input type="checkbox"/> ft. Gravel pack? yes Size range of material 3/16"	
Fine sand			126	145	11. Static water level: <input type="checkbox"/> mo./day/yr. 251 ft. below land surface Date 7/30/76	
Gravel			146	195	12. Pumping level below land surfaces: <input type="checkbox"/> ft. after <input type="checkbox"/> hrs. pumping <input type="checkbox"/> g.p.m. <input type="checkbox"/> ft. after <input type="checkbox"/> hrs. pumping <input type="checkbox"/> g.p.m. Estimated maximum yield 30 g.p.m.	
Med. to lar. sand			196	255	13. Water sample submitted: <input type="checkbox"/> mo./day/yr. Yes <input checked="" type="checkbox"/> No <input type="checkbox"/> Date <input type="checkbox"/>	
Fine sand			256	285	14. Well head completion: <input checked="" type="checkbox"/> Pitless sewer Unit <input type="checkbox"/> Inches above grade	
Med. to lar. sand			286	345	15. Well grouted? yes With: <input type="checkbox"/> Neat cement <input type="checkbox"/> Bentonite <input checked="" type="checkbox"/> Concrete Depth: From 4 ft. to 14 ft.	
Clay			346	348	16. Nearest source of possible contamination: ft. 90 ft. Direction Southwest cesspool 1 Well disinfected upon completion? <input checked="" type="checkbox"/> Yes <input type="checkbox"/> No	
Med. to lar. sand (hard drilling)			349	450	17. Pump: Manufacturer's name Aermotor Model number SD19 HP 3 Volts 220 Length of drop pipe 378 ft. capacity 20 g.p.m. Type: <input checked="" type="checkbox"/> Submersible <input type="checkbox"/> Turbine <input type="checkbox"/> Jet <input type="checkbox"/> Reciprocating <input type="checkbox"/> Centrifugal <input type="checkbox"/> Other	
(Use a second sheet if needed)						
18. Elevation: Topography: <input type="checkbox"/> Hill <input type="checkbox"/> Slope <input checked="" type="checkbox"/> Upland <input type="checkbox"/> Valley	19. Remarks:		20. Water well contractor's certification: This well was drilled under my jurisdiction and this report is true to the best of my knowledge and belief. Friesen Windmill 252 285 Business name License No. Address Meade, Kansas 67864 Signed John F. Lucas Date 8-20-76 Authorized representative			

Forward the white, blue and pink copies to the Department of Health and Environment

Form WWC-5