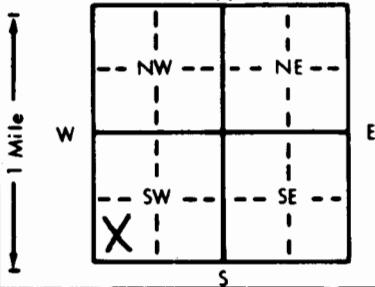


1 LOCATION OF WATER WELL: County: Haskell	Fraction C $\frac{1}{4}$ SW $\frac{1}{4}$ SW $\frac{1}{4}$	Section Number 27	Township Number T 28 S	Range Number R 34 E W
---	---	-----------------------------	----------------------------------	--

Distance and direction from nearest town or city street address of well if located within city?

10 mi N/NW of Satanta, KS

2 WATER WELL OWNER: RR#, St. Address, Box # : City, State, ZIP Code :	Beredco Drilling 401 E. Douglas, Suite 402 Wichita, KS 67202	Doerksen #4-27 Board of Agriculture, Division of Water Resources Application Number: 910559
---	---	--

3 LOCATE WELL'S LOCATION WITH AN "X" IN SECTION BOX: 	4 DEPTH OF COMPLETED WELL: 400 ft. ELEVATION: Depth(s) Groundwater Encountered 1. 380 ft. 2. 380 ft. 3. 380 ft. WELL'S STATIC WATER LEVEL 380 ft. below land surface measured on mo/day/yr 11/07/91 80 Pump test data: Well water was 390 ft. after 1 hours pumping 80 gpm Est. Yield 80 gpm: Well water was 390 ft. after 1 hours pumping 80 gpm Bore Hole Diameter 11 in. to 400 ft. and 11 in. to 400 ft. WELL WATER TO BE USED AS: 1 Domestic 3 Feedlot 6 Oil field water supply 9 Dewatering 11 Injection well 2 Irrigation 4 Industrial 7 Lawn and garden only 10 Monitoring well 12 Other (Specify below) Was a chemical/bacteriological sample submitted to Department? Yes X No X ; If yes, mo/day/yr sample was submitted Water Well Disinfected? Yes X No X
--	--

5 TYPE OF BLANK CASING USED: 1 Steel 3 RMP (SR) 5 Wrought iron 8 Concrete tile 2 PVC 4 ABS 6 Asbestos-Cement 9 Other (specify below) Blank casing diameter 6 in. to 400 ft. Dia. 6 in. to 400 ft. Dia. 6 in. to 400 ft. Dia. 6 in. to 400 ft. Dia. Casing height above land surface 24 in. weight 24 lbs./ft. Wall thickness or gauge No. 032 TYPE OF SCREEN OR PERFORATION MATERIAL: 1 Steel 3 Stainless steel 5 Fiberglass 8 RMP (SR) 10 Asbestos-cement 2 Brass 4 Galvanized steel 6 Concrete tile 9 ABS 11 Other (specify) SCREEN OR PERFORATION OPENINGS ARE: 1 Continuous slot 3 Mill slot 5 Gauzed wrapped 8 Saw cut 11 None (open hole) 2 Louvered shutter 4 Key punched 6 Wire wrapped 9 Drilled holes 7 Torch cut 10 Other (specify) SCREEN-PERFORATED INTERVALS: From 320 ft. to 400 ft. From 320 ft. to 400 ft. From 320 ft. to 400 ft. From 320 ft. to 400 ft. GRAVEL PACK INTERVALS: From 200 ft. to 400 ft. From 200 ft. to 400 ft. From 200 ft. to 400 ft. From 200 ft. to 400 ft.	CASING JOINTS: Glued X Clamped X Welded X Threaded X
--	--

6 GROUT MATERIAL: 1 Neat cement 2 Cement grout 3 Bentonite 4 Other Hole Plug Grout Intervals: From 1 ft. to 20 ft. From 1 ft. to 20 ft. From 1 ft. to 20 ft. From 1 ft. to 20 ft. What is the nearest source of possible contamination: 1 Septic tank 4 Lateral lines 7 Pit privy 10 Livestock pens 14 Abandoned water well 2 Sewer lines 5 Cess pool 8 Sewage lagoon 11 Fuel storage 15 Oil well/Gas well 3 Watertight sewer lines 6 Seepage pit 9 Feedyard 12 Fertilizer storage 16 Other (specify below) 13 Insecticide storage Direction from well? Southeast How many feet? 150

FROM	TO	LITHOLOGIC LOG	FROM	TO	PLUGGING INTERVALS
0	2	Surface Soil			
2	46	Sandy Clay			
46	151	Sand			
151	159	Clay			
159	193	Sand			
193	205	Clay			
205	261	Sand			
261	276	Clay			
276	400	Sand			

7 CONTRACTOR'S OR LANDOWNER'S CERTIFICATION: This water well was (1) constructed, (2) reconstructed, or (3) plugged under my jurisdiction and was completed on (mo/day/year) 11/06/91 and this record is true to the best of my knowledge and belief. Kansas Water Well Contractor's License No. KWWCL-430 . This Water Well Record was completed on (mo/day/yr) 11/06/91 under the business name of Howard Drilling Co. Box 806 BEaver, OK 73932 signature <i>Howard Drilling Co.</i>

INSTRUCTIONS: Use typewriter or ball point pen. PLEASE PRESS FIRMLY and PRINT clearly. Please fill in blanks, underline or circle the correct answers. Send top three copies to Kansas Department of Health and Environment, Bureau of Water, Topeka, Kansas 66620-0001. Telephone: 913-296-5545. Send one to WATER WELL OWNER and retain one for your records.