WATER WELL RECORD Form WWC-5 KSA 82a-1212

1 LOCATION OF WATER WELL: County: HASKELL	Fraction: SE ¼ SE ¼ SE ¼	Section Number: 29	Township Number: T 28 S	Range Number: R 34 E/W

Distance and direction from nearest town or city street address of well if located within city?
9 miles east...1 mile north of Hickok, Ks.

2 WATER WELL OWNER:
RR#, St. Address, Box # : Russell Hicks
City, State, ZIP Code : Santanta, Ks. 67870

Board of Agriculture, Division of Water Resources Application Number:

3 LOCATE WELL'S LOCATION WITH AN "X" IN SECTION BOX:

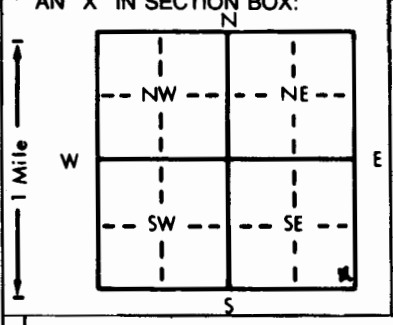

4 DEPTH OF COMPLETED WELL 495 ft. ELEVATION: slope
Depth(s) Groundwater Encountered 1. 260 ft. 2. ft. 3. ft.
WELL'S STATIC WATER LEVEL 260 ft. below land surface measured on mo/day/yr Oct. 15, 1984
Pump test data: Well water was ft. after hours pumping gpm
Est. Yield gpm: Well water was ft. after hours pumping gpm
Bore Hole Diameter 9 3/4 in. to 495 ft., and in. to ft.
WELL WATER TO BE USED AS: 1 Domestic 2 Irrigation 3 Feedlot 4 Industrial 5 Public water supply 6 Oil field water supply 7 Lawn and garden only 8 Air conditioning 9 Dewatering 10 Observation well 11 Injection well 12 Other (Specify below)
Was a chemical/bacteriological sample submitted to Department? Yes No X; If yes, mo/day/yr sample was submitted
Water Well Disinfected? Yes X No

5 TYPE OF BLANK CASING USED: 1 Steel 2 PVC 3 RMP (SR) 4 ABS 5 Wrought iron 6 Asbestos-Cement 7 Fiberglass 8 Concrete tile 9 Other (specify below)
CASING JOINTS: Glued X Clamped riveted Welded Threaded
Blank casing diameter 5 in. to 295 ft., Dia 5 in. to 475 ft., Dia in. to ft.
Casing height above land surface 18 in., weight lbs./ft. Wall thickness or gauge No. schedule 200
TYPE OF SCREEN OR PERFORATION MATERIAL: 1 Steel 2 Brass 3 Stainless steel 4 Galvanized steel 5 Fiberglass 6 Concrete tile 7 PVC 8 RMP (SR) 9 ABS 10 Asbestos-cement 11 Other (specify) 12 None used (open hole)
SCREEN OR PERFORATION OPENINGS ARE: 1 Continuous slot 2 Louvered shutter 3 Mill slot 4 Key punched 5 Gauzed wrapped 6 Wire wrapped 7 Torch cut 8 Saw cut 9 Drilled holes 10 Other (specify) 11 None (open hole)
SCREEN-PERFORATED INTERVALS: From 295 ft. to 335 ft., From ft. to ft.
From 475 ft. to 495 ft., From ft. to ft.
GRAVEL PACK INTERVALS: From 10 ft. to 495 ft., From ft. to ft.
From ft. to ft., From ft. to ft.

6 GROUT MATERIAL: 1 Neat cement 2 Cement grout 3 Bentonite 4 Other
Grout Intervals: From 0 ft. to 10 ft., From ft. to ft., From ft. to ft.
What is the nearest source of possible contamination: 1 Septic tank 2 Sewer lines 3 Watertight sewer lines 4 Lateral lines 5 Cess pool 6 Seepage pit 7 Pit privy 8 Sewage lagoon 9 Feedyard 10 Livestock pens 11 Fuel storage 12 Fertilizer storage 13 Insecticide storage 14 Abandoned water well 15 Oil well/Gas well 16 Other (specify below)
Direction from well? 150 feet west How many feet?

FROM	TO	LITHOLOGIC LOG	FROM	TO	LITHOLOGIC LOG
0	2	Surface			
2	40	Clay and fine sand strips			
40	120	Fine to medium sand			
120	305	Medium to coarse sand			
305	370	Medium sand w/clay strips			
370	475	Clay w/fine sand strips			
475	495	Clay w/medium sand strips			
495	500	Clay			

7 CONTRACTOR'S OR LANDOWNER'S CERTIFICATION: This water well was (1) constructed, (2) reconstructed, or (3) plugged under my jurisdiction and was completed on (mo/day/year) October 15, 1984 and this record is true to the best of my knowledge and belief. Kansas Water Well Contractor's License No. 164. This Water Well Record was completed on (mo/day/yr) August 19, 1985 under the business name of Houck Bros Drilling Co. by (signature) M. Beard

INSTRUCTIONS: Use typewriter or ball point pen, *PLEASE PRESS FIRMLY* and *PRINT* clearly. Please fill in blanks, underline or circle the correct answers. Send top three copies to Kansas Department of Health and Environment, Division of Environment, Environmental Geology Section, Topeka, KS 66620. Send one to WATER WELL OWNER and retain one for your records.

OFFICE USE ONLY T 28 R 34 E/W SEC. 29 SE ¼ SE ¼ SE ¼