WATER WELL RECORD Form WWC-5 KSA 82a-1212

1 LOCATION OF WATER WELL:	Fraction	Section Number	Township Number	Range Number
County: Haskell	¼ NW¼ NW ¼	35	T 28 S	R 34 E/W

Distance and direction from nearest town or city street address of well if located within city?
9N of Satanta 1 W 3/4 N.

2 WATER WELL OWNER: Myrtle-Lesley Amoco Production
RR#, St. Address, Box # : Box 432
City, State, ZIP Code : Liberal, Ks. 67901

Board of Agriculture, Division of Water Resources
Application Number: T84-912

3 LOCATE WELL'S LOCATION WITH AN "X" IN SECTION BOX:

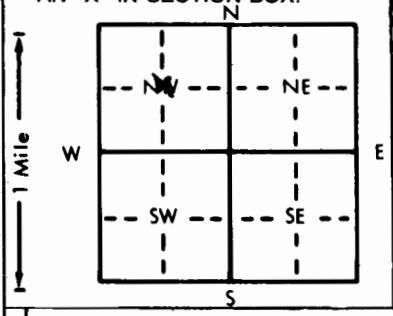

4 DEPTH OF COMPLETED WELL 400 ft. ELEVATION:
Depth(s) Groundwater Encountered 1. 105 ft. 2. ft. 3. ft.
WELL'S STATIC WATER LEVEL 295 ft. below land surface measured on mo/day/yr 12/8/84
Pump test data: Well water was 340 ft. after 2 hours pumping 45 gpm
Est. Yield 55 gpm: Well water was ft. after hours pumping gpm
Bore Hole Diameter 9 in. to 400 ft., and in. to ft.
WELL WATER TO BE USED AS: 5 Public water supply 8 Air conditioning 11 Injection well
1 Domestic 3 Feedlot 6 Oil field water supply 9 Dewatering 12 Other (Specify below)
2 Irrigation 4 Industrial 7 Lawn and garden only 10 Observation well
Was a chemical/bacteriological sample submitted to Department? Yes ..... No X ; If yes, mo/day/yr sample was submitted
Water Well Disinfected? Yes X No

5 TYPE OF BLANK CASING USED: 5 Wrought iron 8 Concrete tile CASING JOINTS: Glued X Clamped
1 Steel 3 RMP (SR) 6 Asbestos-Cement 9 Other (specify below) Welded
2 PVC 4 ABS 7 Fiberglass Threaded
Blank casing diameter 5 in. to 320 ft., Dia in. to ft., Dia in. to ft.
Casing height above land surface 14 in., weight 200 lbs./ft. Wall thickness or gauge No. 0.265
TYPE OF SCREEN OR PERFORATION MATERIAL: 7 PVC 10 Asbestos-cement
1 Steel 3 Stainless steel 5 Fiberglass 8 RMP (SR) 11 Other (specify)
2 Brass 4 Galvanized steel 6 Concrete tile 9 ABS 12 None used (open hole)
SCREEN OR PERFORATION OPENINGS ARE: 5 Gauzed wrapped 8 Saw cut 11 None (open hole)
1 Continuous slot 3 Mill slot 6 Wire wrapped 9 Drilled holes
2 Louvered shutter 4 Key punched 7 Torch cut 10 Other (specify)
SCREEN-PERFORATED INTERVALS: From 295 ft. to 400 ft., From ft. to ft.
From ft. to ft., From ft. to ft.
GRAVEL PACK INTERVALS: From 280 ft. to 400 ft., From ft. to ft.
From ft. to ft., From ft. to ft.

6 GROUT MATERIAL: 1 Neat cement 2 Cement grout 3 Bentonite 4 Other
Grout Intervals: From 0 ft. to 10 ft., From ft. to ft., From ft. to ft.
What is the nearest source of possible contamination: 10 Livestock pens 14 Abandoned water well
1 Septic tank 4 Lateral lines 7 Pit privy 11 Fuel storage 15 Oil well/Gas well
2 Sewer lines 5 Cess pool 8 Sewage lagoon 12 Fertilizer storage 16 Other (specify below)
3 Watertight sewer lines 6 Seepage pit 9 Feedyard 13 Insecticide storage
Direction from well? SW How many feet? 200

FROM	TO	LITHOLOGIC LOG	FROM	TO	LITHOLOGIC LOG
0	295	Overburden			
295	360	Med. to Coarse Sand			
360	380	Med. Sand & Clay streaks			
380	400	Med Sand			

7 CONTRACTOR'S OR LANDOWNER'S CERTIFICATION: This water well was (1) constructed, (2) reconstructed, or (3) plugged under my jurisdiction and was completed on (mo/day/year) 12/8/84 and this record is true to the best of my knowledge and belief. Kansas Water Well Contractor's License No. 142 This Water Well Record was completed on (mo/day/yr) 12/8/84
under the business name of T&W Water Well Service by (signature) [signature]

INSTRUCTIONS: Use typewriter or ball point pen, *PLEASE PRESS FIRMLY* and *PRINT* clearly. Please fill in blanks, underline or circle the correct answers. Send top three copies to Kansas Department of Health and Environment, Division of Environment, Environmental Geology Section, Topeka, KS 66620. Send one to WATER WELL OWNER and retain one for your records.

OFFICE USE ONLY T R E/W SEC. ¼ ¼ ¼ ¼