WATER WELL RECORD Form WWC-5 KSA 82a-1212

1 LOCATION OF WATER WELL:	Fraction	Section Number	Township Number	Range Number
County: HASKELL	SW ¼ SW ¼ SE ¼	26	T 28 S	R 34 E/W

Distance and direction from nearest town or city street address of well if located within city?

7 North, 8½ West of Sublett, Kansas

2 WATER WELL OWNER: Lorraine Wright

RR#, St. Address, Box # : Rt. #1, Box 108

City, State, ZIP Code : Satanta, KS 67870

Board of Agriculture, Division of Water Resources Application Number: ---

3 LOCATE WELL'S LOCATION WITH AN "X" IN SECTION BOX:

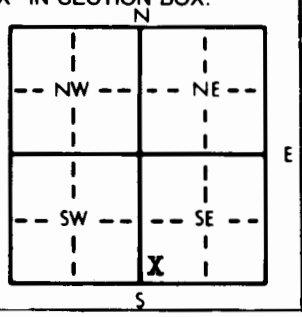

4 DEPTH OF COMPLETED WELL 500 ft. ELEVATION: Slope

Depth(s) Groundwater Encountered 1. Not available ft. 2. ft. 3. ft.

WELL'S STATIC WATER LEVEL 310 ft. below land surface measured on mo/day/yr December 5, 1990

Pump test data: Well water was ft. after hours pumping gpm

Est. Yield 20 gpm: Well water was ft. after hours pumping gpm

Bore Hole Diameter 10 in. to 500 ft., and in. to ft.

WELL WATER TO BE USED AS: 5 Public water supply 8 Air conditioning 11 Injection well

XX Domestic 3 Feedlot 6 Oil field water supply 9 Dewatering 12 Other (Specify below)

2 Irrigation 4 Industrial 7 Lawn and garden only 10 Monitoring well

Was a chemical/bacteriological sample submitted to Department? Yes No XX; If yes, mo/day/yr sample was submitted Water Well Disinfected? Yes XX No

5 TYPE OF BLANK CASING USED: 5 Wrought iron 8 Concrete tile CASING JOINTS: Glued XX Clamped

1 Steel 3 RMP (SR) 6 Asbestos-Cement 9 Other (specify below) Welded

XX PVC 4 ABS 7 Fiberglass Threaded

Blank casing diameter 5 in. to 440 ft., Dia in. to ft., Dia in. to ft.

Casing height above land surface 18 in., weight 2.8 lbs./ft. Wall thickness or gauge No. .265

TYPE OF SCREEN OR PERFORATION MATERIAL: XX PVC 10 Asbestos-cement

1 Steel 3 Stainless steel 5 Fiberglass 8 RMP (SR) 11 Other (specify)

2 Brass 4 Galvanized steel 6 Concrete tile 9 ABS 12 None used (open hole)

SCREEN OR PERFORATION OPENINGS ARE: 5 Gauzed wrapped XX Saw cut 11 None (open hole)

1 Continuous slot 3 Mill slot 6 Wire wrapped 9 Drilled holes

2 Louvered shutter 4 Key punched 7 Torch cut 10 Other (specify)

SCREEN-PERFORATED INTERVALS: From 440 ft. to 500 ft., From ft. to ft.

From ft. to ft., From ft. to ft.

GRAVEL PACK INTERVALS: From 20 ft. to 500 ft., From ft. to ft.

From ft. to ft., From ft. to ft.

6 GROUT MATERIAL: 1 Neat cement 2 Cement grout 3 Bentonite XX Other Baroid Hole Plug

Grout Intervals: From 0 ft. to 20 ft., From ft. to ft., From ft. to ft.

What is the nearest source of possible contamination: 10 Livestock pens 14 Abandoned water well

XX Septic tank 4 Lateral lines 7 Pit privy 11 Fuel storage 15 Oil well/Gas well

2 Sewer lines 5 Cess pool 8 Sewage lagoon 12 Fertilizer storage 16 Other (specify below)

3 Watertight sewer lines 6 Seepage pit 9 Feedyard 13 Insecticide storage

Direction from well? North How many feet? 150

FROM	TO	LITHOLOGIC LOG	FROM	TO	PLUGGING INTERVALS
0	3	Topsoil			
3	54	Clay			
54	71	Med. to Lgr. Sand			
71	391	Blue Clay			
391	497	Fine Sand			
497	500	Blue Clay			

7 CONTRACTOR'S OR LANDOWNER'S CERTIFICATION: This water well was (1) constructed, (2) reconstructed, or (3) plugged under my jurisdiction and was completed on (mo/day/year) December 5, 1990 and this record is true to the best of my knowledge and belief. Kansas Water Well Contractor's License No. 252 This Water Well Record was completed on (mo/day/yr) December 17, 1990 under the business name of Friesen Windmill & Supply Inc. by (signature)

INSTRUCTIONS: Use typewriter or ball point pen. *PLEASE PRESS FIRMLY* and *PRINT* clearly. Please fill in blanks, underline or circle the correct answers. Send top three copies to Kansas Department of Health and Environment, Bureau of Water, Topeka, Kansas 66620-7320. Telephone: 913-296-5545. Send one to WATER WELL OWNER and retain one for your records.

22-9001260175

OFFICE USE ONLY T R E/W SEC. ¼ ¼ ¼