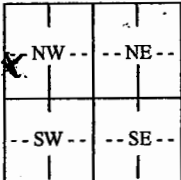
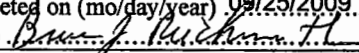


WATER WELL RECORD

Form WWC-5

Division of Water Resources App. No.

23,103

1 LOCATION OF WATER WELL: County: Haskell		Fraction $\frac{1}{4}$ NW $\frac{1}{4}$ SW $\frac{1}{4}$ NW $\frac{1}{4}$	Section Number 34	Township No. T 28 S	Range Number R 34 <input type="checkbox"/> E <input checked="" type="checkbox"/> W	
Street/Rural Address of Well Location; if unknown, distance & direction from nearest town or intersection: If at owner's address, check here <input type="checkbox"/> From the intersection of Hwy. 83 & Hwy. 160; 9 miles West, 3,800 feet North to drill site			Global Positioning System (GPS) information: Latitude: 37.57267 (in decimal degrees) Longitude: -101.03531 (in decimal degrees) Elevation: Datum: <input type="checkbox"/> WGS 84, <input type="checkbox"/> NAD 83, <input checked="" type="checkbox"/> NAD 27 Collection Method: <input checked="" type="checkbox"/> GPS unit (Make/Model: Magel/Triton 300) <input type="checkbox"/> Digital Map/Photo, <input type="checkbox"/> Topographic Map, <input type="checkbox"/> Land Survey Est. Accuracy: <input type="checkbox"/> <3 m, <input type="checkbox"/> 3-5 m, <input type="checkbox"/> 5-15 m, <input type="checkbox"/> >15 m	
2 WATER WELL OWNER: Clawson Land Partnership RR#, Street Address, Box #: P.O. Box 279 City, State, ZIP Code : Plains, KS 67870	
3 LOCATE WELL WITH AN "X" IN SECTION BOX: N W  E S -----1 mile-----		4 DEPTH OF COMPLETED WELL 540 ft. Depth(s) Groundwater Encountered (1)..... ft. (2)..... ft. (3)..... ft. WELL'S STATIC WATER LEVEL 387 ft. below land surface measured on mo/day/yr..... Pump test data: Well water was 502 ft. after 4 hours pumping 430 gpm EST. YIELD 430 gpm. Well water was..... ft. after..... hours pumping..... gpm Bore Hole Diameter 24 in. to 540 ft., and..... in. to..... ft. WELL WATER TO BE USED AS: <input type="checkbox"/> Public water supply <input type="checkbox"/> Geothermal <input type="checkbox"/> Injection well <input type="checkbox"/> Domestic <input type="checkbox"/> Feedlot <input type="checkbox"/> Oil field water supply <input type="checkbox"/> Dewatering <input type="checkbox"/> Other (Specify below) <input checked="" type="checkbox"/> Irrigation <input type="checkbox"/> Industrial <input type="checkbox"/> Domestic-lawn & garden <input type="checkbox"/> Monitoring well Was a chemical/bacteriological sample submitted to Department? <input type="checkbox"/> Yes <input checked="" type="checkbox"/> No If yes, mo/day/yr sample was submitted..... Water well disinfected? <input checked="" type="checkbox"/> Yes <input type="checkbox"/> No	
5 TYPE OF CASING USED: <input checked="" type="checkbox"/> Steel <input type="checkbox"/> PVC <input type="checkbox"/> Other CASING JOINTS: <input type="checkbox"/> Glued <input type="checkbox"/> Clamped <input type="checkbox"/> Welded <input type="checkbox"/> Threaded Casing diameter .16 in. to 540 ft., Diameter..... in. to..... ft., Diameter..... in. to..... ft. Casing height above land surface 12 in., Weight 42 lbs./ft., Wall thickness or gauge No. 250 TYPE OF SCREEN OR PERFORATION MATERIAL: <input checked="" type="checkbox"/> Steel <input type="checkbox"/> Stainless Steel <input type="checkbox"/> PVC <input type="checkbox"/> Other (Specify) <input type="checkbox"/> Brass <input type="checkbox"/> Galvanized Steel <input type="checkbox"/> None used (open hole) SCREEN OR PERFORATION OPENINGS ARE: <input type="checkbox"/> Continuous slot <input type="checkbox"/> Mill slot <input type="checkbox"/> Gauze wrapped <input type="checkbox"/> Torch cut <input type="checkbox"/> Drilled holes <input type="checkbox"/> None (open hole) <input type="checkbox"/> Louvered shutter <input type="checkbox"/> Key punched <input checked="" type="checkbox"/> Wire wrapped <input type="checkbox"/> Saw cut <input type="checkbox"/> Other (specify) SCREEN-PERFORATED INTERVALS: From 407 ft. to 447 ft., From 475 ft. to 535 ft., From..... ft. to..... ft., From..... ft. to..... ft. GRAVEL PACK INTERVALS: From 20 ft. to 540 ft., From..... ft. to..... ft., From..... ft. to..... ft., From..... ft. to..... ft.	
6 GROUT MATERIAL: <input type="checkbox"/> Neat cement <input type="checkbox"/> Cement grout <input checked="" type="checkbox"/> Bentonite <input type="checkbox"/> Other Grout Intervals: From 0 ft. to 20 ft., From..... ft. to..... ft., From..... ft. to..... ft. What is the nearest source of possible contamination: <input type="checkbox"/> Septic tank <input type="checkbox"/> Lateral lines <input type="checkbox"/> Pit privy <input type="checkbox"/> Livestock pens <input type="checkbox"/> Insecticide storage <input type="checkbox"/> Other (specify below) <input type="checkbox"/> Sewer lines <input type="checkbox"/> Cesspool <input type="checkbox"/> Sewage lagoon <input type="checkbox"/> Fuel storage <input checked="" type="checkbox"/> Abandoned water well <input type="checkbox"/> Watertight sewer lines <input type="checkbox"/> Seepage pit <input type="checkbox"/> Feedyard <input type="checkbox"/> Fertilizer storage <input type="checkbox"/> Oil well/gas well Direction from well North Distance from well 1,300 Feet	
<table border="1" style="width:100%; border-collapse: collapse;"> <thead> <tr> <th>FROM</th> <th>TO</th> <th>LITHOLOGIC LOG</th> <th>FROM</th> <th>TO</th> <th>LITHO. LOG (cont.) or PLUGGING INTERVALS</th> </tr> </thead> <tbody> <tr> <td>0'</td> <td>2'</td> <td>Top Soil</td> <td>246'</td> <td>262'</td> <td>Brown Sandy Clay</td> </tr> <tr> <td>2'</td> <td>60'</td> <td>Brown Sandy Clay</td> <td>262'</td> <td>274'</td> <td>Sand Fn. to Med.</td> </tr> <tr> <td>60'</td> <td>92'</td> <td>Sand Fn. to Med., Sm. to Lg. Gravel</td> <td>274'</td> <td>279'</td> <td>Brown Sandy Clay</td> </tr> <tr> <td>92'</td> <td>102'</td> <td>Brown Sandy Clay</td> <td>279'</td> <td>317'</td> <td>Sand Fn. to Med. Coarse</td> </tr> <tr> <td>102'</td> <td>151'</td> <td>Sand Fn. to Med., Sm. to Lg. Gravel</td> <td>317'</td> <td>346'</td> <td>Grey and Blue Sandy Clays</td> </tr> <tr> <td>151'</td> <td>160'</td> <td>Sand Fn. to Med., Cemented Ledges</td> <td>346'</td> <td>447'</td> <td>Sand Fn. to Med. Coarse</td> </tr> <tr> <td>160'</td> <td>185'</td> <td>Brown Sandy Clay</td> <td>447'</td> <td>517'</td> <td>Brown Sandy, Sluffing Clays</td> </tr> <tr> <td>185'</td> <td>234'</td> <td>Sand Fn. to Med., Some Sm. Gravel</td> <td>517'</td> <td>535'</td> <td>Sand Fn. to Med., Brwn Rock Ledges</td> </tr> <tr> <td>234'</td> <td>237'</td> <td>Brown Sandy Clay</td> <td>535'</td> <td>540'</td> <td>Yellow and Grey Soapstone</td> </tr> <tr> <td>237'</td> <td>246'</td> <td>Sand Fn. to Med. Coarse</td> <td></td> <td></td> <td></td> </tr>
7 CONTRACTOR'S OR LANDOWNER'S CERTIFICATION: This water well was <input checked="" type="checkbox"/> constructed, <input type="checkbox"/> reconstructed, or <input type="checkbox"/> plugged under my jurisdiction and was completed on (mo/day/year) 08/24/2009 and this record is true to the best of my knowledge and belief. Kansas Water Well Contractor's License No. 145. This Water Well Record was completed on (mo/day/year) 09/25/2009 under the business name of Henkle Drilling & Supply Co. Inc. by (signature) 	
INSTRUCTIONS: Use typewriter or ball point pen. PLEASE PRESS FIRMLY and PRINT clearly. Please fill in blanks and check the correct answers. Send three copies (white, blue, pink) to Kansas Department of Health and Environment, Bureau of Water, Geology Section, 1000 SW Jackson St., Suite 420, Topeka, Kansas 66612-1367. Telephone 785-296-5522. Send one copy to WATER WELL OWNER and retain one for your records. Include fee of \$5.00 for each constructed well. Visit us at http://www.kdheks.gov/waterwell/index.html .	