

USE TYPEWRITER OR BALL POINT PEN—PRESS FIRMLY, PRINT CLEARLY.

T R EW sec 1/4 1/4 1/4 No.

WATER WELL RECORD
KSA 82a-1201-1215

Kansas State Dept. Of Health
(Water Well Contractors)
Forbes-Bldg. 740
Topeka, Kansas 66620


1 Location of well:	County Grant	Township name Sherman	Fraction NE NW SE	Section number 7	Town number 28 S	Range number 35W
---------------------	------------------------	---------------------------------	-----------------------------	----------------------------	----------------------------	----------------------------

Distance and direction from nearest town or city:
4 1/2 North, 3 East, 1/4 miles West of Hickok, Ks.

Street address of well location if in city:

3 Owner of well:
Garey Covey

Address:
Satanta, Kansas

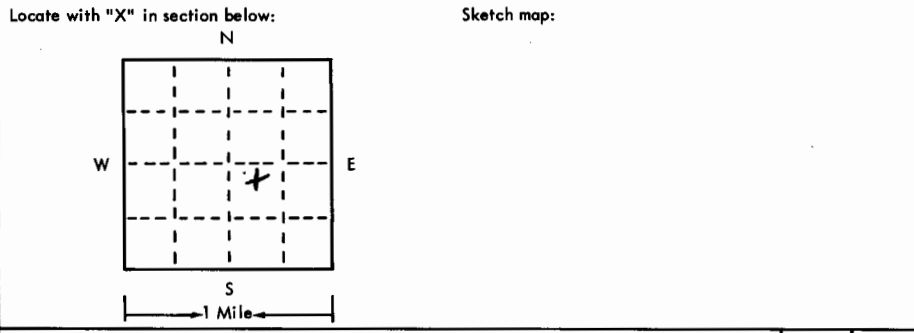

4 Well depth: **452.7** ft. Date of completion **2/22/75**
Well diameter **27** in.

5 Cable tool Rotary Driven Dug
 Hollow rod Jetted Bored Reverse rotary

6 Use: Domestic Public supply Industry
 Irrigation Air conditioning Commercial
 Test well

7 Casing: Material **steel** Height: **above**/below
Threading: Threaded Welded Surface **12** in.
Diam. **16 inch** Weight **36.8** lbs./ft.
16 in. to **311.7** ft. depth Drive shoe? Yes No
— in. to — ft. depth

2 Type and color of material	From	To
Surface	0	2
Sandy clay	2	68
Medium to coarse sand	68	120
Coarse sand and gravel	120	158
Medium to coarse sand w/small clay breakers	158	265
Medium to coarse sand	265	352
Medium to coarse sand with hard strips	352	370
Med /Medium to coarse sand	370	440
Medium to coarse sand w/clay breakers	440	450
(use a second sheet if needed)		

8 Screen: **Lakewood**
Manufacturer
Type **steel** Dia. **16 inch**
3/16 Slot gauge Length **2 inch**
Set between **10.4** ft. and **452.7** ft.
Fittings:
Gravel pack Yes No Size range of material **1/4 to 5/8**

9 Static water level:
269 ft. below land surface Date **2/20/75**

10 Pumping level below land surfaces:
285.6 ft. after **10.4** hrs. pumping **1400** g.p.m.
— ft. after — hrs. pumping — g.p.m.
Estimated maximum yield **1400** g.p.m.

11 Water sample submitted:
 Yes No Date —

12 Well head completion:
 Pitless adapter **12** inches above grade

13 Well grouted? Yes No
 Neat cement Bentonite
Depth: From **0** ft. to **10** ft.

14 Nearest source of possible contamination:
ft. **1/2 mile** Direction **east** Type **house**
Well disinfected upon completion? Yes No

15 Pump: Not installed
Manufacturer's name _____
Model number _____ HP _____ Volts _____
Length of drop pipe _____ ft. capacity _____ g.m.p.
Type:
 Submersible Turbine
 Jet Reciprocating
 Centrifugal Other

16 Remarks: elevation

Wheat field

Topography:

Hill
 Slope
 Upland
 Valley

17 Water well contractor's certification:
This well was drilled under my jurisdiction and this report is true to the best of my knowledge and belief.
Houck Bros. Drilling Co.

Business name _____ License No. **164**
Address **487, Ulysses, Ks.**
Signed **M. Beard** Date **3/20/75**
Authorized representative