

USE TYPEWRITER OR BALL POINT PEN-PRESS FIRMLY, PRINT CLEARLY.


WATER WELL RECORD
KSA 82a-1201-1215

T R EW sec 1/4 1/4 1/4 No.

Kansas State Dept. Of Health
(Water Well Contractors)
Forbes-Bldg. 740
Topeka, Kansas 66620

1 Location of well:	County Grant	Township name	Fraction Center SW 1/4	Section number 20	Town number T28S	Range number R35W
---------------------	------------------------	---------------	----------------------------------	-----------------------------	----------------------------	-----------------------------

Distance and direction from nearest town or city: 3 mi. East, 2 1/4 mi. N., 1/4 mi. East of Hickok Street address of well location if in city:	3 Owner of well: Ralph Green Address: 206 East 5th Pratt, Kansas 67124
---	---

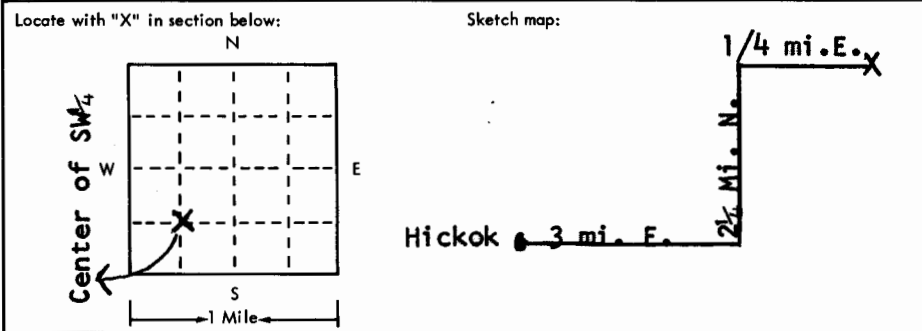

2	Type and color of material	From	To
	Brown Sandy Clay & Surface	0	15
	Brown Sandy Clay	15	45
	Fine Sand	45	75
	Medium Sand	75	105
	Brown Clay	105	120
	Sand	120	150
	Brown Sandy Clay	150	180
	Brown Clay	180	240
	Coarse Sand	240	265
	Brown Clay	265	270
	Coarse Sand (Good - Loose)	270	420
	Brown Clay	420	450
	Fine Sand	450	470
	Brown Clay	470	535
	Blue Shale	535	540
	(use a second sheet if needed)		

4 Well depth: 480 ft. Date of completion 3-29-76 Well diameter 26 in.
5 <input type="checkbox"/> Cable tool <input type="checkbox"/> Rotary <input type="checkbox"/> Driven <input type="checkbox"/> Dug <input type="checkbox"/> Hollow rod <input type="checkbox"/> Jetted <input type="checkbox"/> Bored <input checked="" type="checkbox"/> Reverse rotary
6 Use: <input type="checkbox"/> Domestic <input type="checkbox"/> Public supply <input type="checkbox"/> Industry <input checked="" type="checkbox"/> Irrigation <input type="checkbox"/> Air conditioning <input type="checkbox"/> Commercial <input type="checkbox"/> Test well
7 Casing: Material Steel Height: above As low Threaded <input type="checkbox"/> Welded <input checked="" type="checkbox"/> Surface 12 in. Diam. 16 in. to 480 ft. depth Drive shoe? <input type="checkbox"/> Yes <input checked="" type="checkbox"/> No Weight 34.5 lbs./ft.

8 Screen: Manufacturer Johnson Type Galvanized Dia. 16 in. Slot 100x100 Length 40 ft. Set between 380 ft. and 420 ft. Fittings: * See remarks Gravel pack <input checked="" type="checkbox"/> Yes <input type="checkbox"/> No Size range of material 1/2 down
--

9 Static water level: 290 ft. below land surface Date 4-2-76
10 Pumping level below land surfaces: 320 ft. after 2 hrs. pumping 800 g.p.m. ____ ft. after ____ hrs. pumping ____ g.p.m. Estimated maximum yield 1800 g.p.m.

11 Water sample submitted: <input type="checkbox"/> Yes <input checked="" type="checkbox"/> No Date _____
12 Well head completion: 12 in. <input type="checkbox"/> Pitless adapter <input checked="" type="checkbox"/> Inches above grade

13 Well grouted? <input checked="" type="checkbox"/> Yes <input type="checkbox"/> No <input checked="" type="checkbox"/> Neat cement <input checked="" type="checkbox"/> Bentonite <input type="checkbox"/> _____ Depth: From 0 ft. to 10 ft.

14 Nearest source of possible contamination: None in field ft. _____ Direction _____ Type _____ Well disinfected upon completion? <input type="checkbox"/> Yes <input checked="" type="checkbox"/> No
--

15 Pump: <input type="checkbox"/> Not installed Manufacturer's name Goulds Model number 12J HP 200 Volts _____ Length of drop pipe 380 ft. capacity 1800 g.p.m. Type: <input type="checkbox"/> Submersible <input checked="" type="checkbox"/> Turbine <input type="checkbox"/> Jet <input type="checkbox"/> Reciprocating <input type="checkbox"/> Centrifugal <input type="checkbox"/> Other

16 Remarks: elevation Topography: <input type="checkbox"/> Hill <input checked="" type="checkbox"/> Slope <input type="checkbox"/> Upland <input type="checkbox"/> Valley	Drilling Sub-contracted to Minter-Wilson Drilling Co. Garden City, Kansas 67846 * Lakewood Perf. Slot 125 X 66 Set between 270' & 380' and 420' X 470'	License #208
--	---	---------------------

17 Water well contractor's certification: This well was drilled under my jurisdiction and this report is true to the best of my knowledge and belief. K. I. Drilling Co., Inc. 263 Business name License No. Address P.O. Box 669, Ulysses, Kn. Signed M. J. [Signature] Date 4-19-76 Authorized representative

28 35W 20 05W