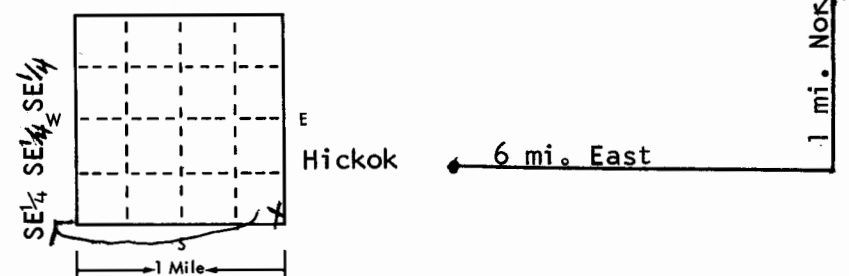


USE TYPEWRITER OR BALL POINT PEN-PRESS FIRMLY, PRINT CLEARLY.

T R EW sec 1/4 1/4 1/4 No.

WATER WELL RECORD
KSA 82a-1201-1215

Kansas State Dept. Of Health
(Water Well Contractors)
Forbes-Bldg. 740
Topeka, Kansas 66620

1 Location of well:	County Grant	Township name	Fraction SE 1/4 SE 1/4 SE 1/4	Section number 26	Town number T28S	Range number R35W
Distance and direction from nearest town or city: 6 Mi. East & 1 Mi. North of Hickok Street address of well location if in city:				3 Owner of well: Pickens Bros. Address: Sayanta, Kansas 67870		
Locate with "X" in section below: N  Sketch map: Hickok ← 6 mi. East 1 mi. North			4 Well depth: 580 ft. Date of completion _____ Well diameter 26 in.			
2 Type and color of material			From		To	
			Surface		0 2	
Sandy Clay		2		45		
Coarse Sand & Gravel		45		160		
Med. to Coarse Sand with Clay Breakers		160		274		
Sandy Clay with Sand Strips		274		283		
Med. to Coarse Sand with Clay Breakers 50%		283		344		
Sandy Clay with Very Fine to Fine Sand		344		385		
Sandy Clay, Sandrock & Dakota 60%		385		412		
Rainbow Clay, Sandrock & Dakota 20%		412		442		
Gray Clay, Sandrock & Dakota 25%		442		468		
75% Brown Shale & Dakota (started taking water)		468		544		
Blue Clay & Dakota 10%		544		560		
" " " (tight)		560		585		
(use a second sheet if needed)						
16 Remarks: elevation Topography: <input type="checkbox"/> Hill <input checked="" type="checkbox"/> Slope <input type="checkbox"/> Upland <input type="checkbox"/> Valley			17 Water well contractor's certification: This well was drilled under my jurisdiction and this report is true to the best of my knowledge and belief. K. I. Drilling Co., Inc. 263 Business name _____ License No. _____ Address Box 669, Ulysses, Kan. Signed [Signature] Date 8-26-75 Authorized Representative			

Forward the white, blue and pink copies to the Kansas State Dept. Of Health.

Form WWC-5