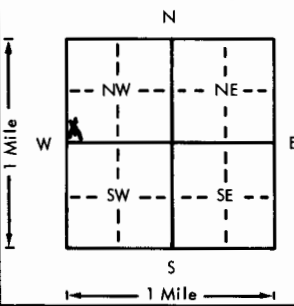


USE TYPEWRITER OR BALL POINT PEN-PRESS FIRMLY, PRINT CLEARLY.

WATER WELL RECORD
KSA 82a-1201-1215

Kansas Department of Health and Environment-Division of Environment (Water well Contractors) Topeka, Kansas 66620

1. Location of well:	County Grant	Fraction SW 1/4 SW 1/4 NW 1/4	Section number 27	Township number T 28 S R 35	EW
2. Distance and direction from nearest town or city: from Hickok, Ks. 5 miles east, 1 1/2 miles north			3. Owner of well: National Benevolence Assoc. % Larry Kepley City, state, zip code: Ulysses, Ks. 67880		
4. Locate with "X" in section below: 			6. Bore hole dia. 26 in. Completion date 6/15/79 Well depth 553 ft.		
5. Type and color of material			7. <input type="checkbox"/> Cable tool <input checked="" type="checkbox"/> Rotary <input type="checkbox"/> Driven <input type="checkbox"/> Dug <input type="checkbox"/> Hollow rod <input type="checkbox"/> Jetted <input type="checkbox"/> Bored <input type="checkbox"/> Reverse rotary		
			8. Use: <input type="checkbox"/> Domestic <input type="checkbox"/> Public supply <input type="checkbox"/> Industry <input checked="" type="checkbox"/> Irrigation <input type="checkbox"/> Air conditioning <input type="checkbox"/> Stock <input type="checkbox"/> Lawn <input type="checkbox"/> Oil field water <input type="checkbox"/> Other		
			9. Casing: Material steel Height (Above) or below Threaded <input type="checkbox"/> Welded <input checked="" type="checkbox"/> Surface 16 in. RMP <input type="checkbox"/> PVC <input type="checkbox"/> Weight 36.8 lbs./ft. Dia. 16 in. to 291.6 ft. depth Wall Thickness: inches or Dia. <input type="checkbox"/> in. to <input type="checkbox"/> ft. depth gage No. 219		
			10. Screen: Manufacturer's name Lakewood Pipe of Texas Type steel Dia. 16" Slot/gauze 3/16" Length 261.6' Set between 291.6 ft. and 553 ft. Gravel pack? <input checked="" type="checkbox"/> Size range of material 1/2 x 5/8"		
			11. Static water level: 259.4 ft. below land surface Date 6-20-79 mo./day/yr.		
			12. Pumping level below land surfaces: 440 ft. after 55.4 hrs. pumping 469 g.p.m. ____ ft. after ____ hrs. pumping ____ g.p.m. Estimated maximum yield 600 g.p.m.		
			13. Water sample submitted: ____ mo./day/yr. <input type="checkbox"/> Yes <input checked="" type="checkbox"/> No Date ____		
			14. Well head completion: <input type="checkbox"/> Pitless adapter 16 Inches above grade		
			15. Well grouted? <input checked="" type="checkbox"/> With: <input checked="" type="checkbox"/> Neat cement <input type="checkbox"/> Bentonite <input type="checkbox"/> Concrete Depth: From 0 ft. to 10 ft.		
			16. Nearest source of possible contamination: ft. ____ Direction ____ Type field Well disinfected upon completion? <input type="checkbox"/> Yes <input checked="" type="checkbox"/> No		
			17. Pump: <input checked="" type="checkbox"/> Not installed Manufacturer's name ____ Model number ____ HP ____ Volts ____ Length of drop pipe ____ ft. capacity ____ g.p.m. Type: <input type="checkbox"/> Submersible <input type="checkbox"/> Turbine <input type="checkbox"/> Jet <input type="checkbox"/> Reciprocating <input type="checkbox"/> Centrifugal <input type="checkbox"/> Other		
18. Elevation:			20. Water well contractor's certification: This well was drilled under my jurisdiction and this report is true to the best of my knowledge and belief. Houck Bros. Drlg. Co. 164 Business name Box 487, Ulysses, Ks. License No. ____ Address ____ Signed M. Beard Date 11/21/79 Authorized representative		
19. Remarks: Topography: <input type="checkbox"/> Hill <input checked="" type="checkbox"/> Slope <input type="checkbox"/> Upland <input type="checkbox"/> Valley					

28 35 W 27 SWS 1/4 1/4 1/4