USE TYPEWRITER OR BALL POINT PEN-PRESS FIRMLY, PRINT CLEARLY.

T	R	EW	sec 1/4	1/4	1/4	No.

WATER WELL RECORD
KSA 82a-1201-1215

Kansas State Dept. Of Health
(Water Well Contractors)
Forbes-Bldg. 740
Topeka, Kansas 66620

1 Location of well: County	Township name	Fraction	Section number	Town number	Range number
Grant		SE¼, SW¼, NE¼	28	T28S	R35W

Distance and direction from nearest town or city: 5East, 1¼North, & ¼ East of Hickok

Street address of well location if in city:

3 Owner of well: Ivan Schmidt
Address: RFD 1
Neodesha, Kansas 66757'

Locate with "X" in section below:

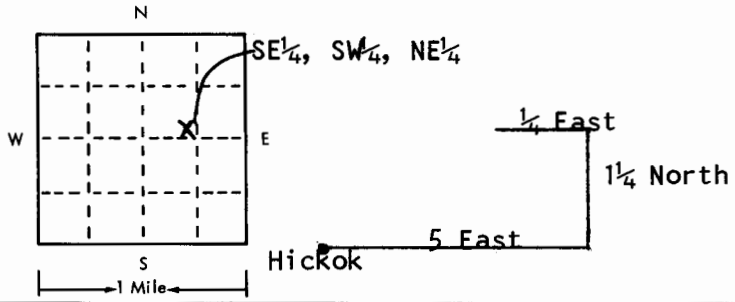

4 Well depth: 460 ft. Date of completion 5/10/75
Well diameter 26 in.

5 ☐ Cable tool ☐ Rotary ☐ Driven ☐ Dug ☐ Hollow rod ☐ Jetted ☐ Bored ☒ Reverse rotary

6 Use: ☐ Domestic ☐ Public supply ☐ Industry ☒ Irrigation ☐ Air conditioning ☐ Commercial ☐ Test well ☐

7 Casing: Material steel Height: above/~~below~~
Threaded ☐ Welded ☒ Surface 12 in.
Diam. 16 in. to 460 ft. depth Weight 34.25 lbs./ft.
___ in. to ___ ft. depth Drive shoe? ☐ Yes ☒ No

2

Type and color of material	From	To
Surface	0	2
Sandy Clay	2	40
Coarse Sand	40	140
Brown Clay	140	212
Medium to Coarse Sand	212	260
Blown Clay	260	270
Medium to Coarse Sand with Clay Breakers	270	320
Clay in fine sand strips	320	420

(use a second sheet if needed)

8 Screen:
Manufacturer Johnson
Type Galvanized Dia. 16"
Slot/~~gauze~~ 100x100 Length 20 Ft.
Set between 300 ft. and 320 ft.
*Fittings: See Remarks
Gravel pack ☒ Yes ☐ No Size range of material ½ down

9 Static water level:
255 ft. below land surface Date 4/30/75

10 Pumping level below land surfaces:
285 ft. after 6 hrs. pumping 1000 g.p.m.
___ ft. after ___ hrs. pumping ___ g.p.m.
Estimated maximum yield 1000 g.p.m.

11 Water sample submitted:
☐ Yes ☒ No Date ___

12 Well head completion:
☐ Pitless adapter 12 Inches above grade

13 Well grouted? ☒ Yes ☐ No
☒ Neat cement ☒ Bentonite ☐ ___
Depth: From 0 ft. to 10 ft.

14 Nearest source of possible contamination: in field
ft. ___ Direction NONE Type ___
Well disinfected upon completion? ☐ Yes ☒ No

15 Pump: ☐ Not installed
Manufacturer's name Goulds
Model number 12J HP 150 Volts ___
Length of drop pipe 320 ft. capacity 1000 g.p.m.
Type:
☐ Submersible ☒ Turbine
☐ Jet ☐ Reciprocating
☐ Certrifugal ☐ Other

16 Remarks: elevation

K.I. Drilling Sub-Contracted to
Minter Wilson Drilling Co.Inc.
Garden City, Kansas
*Lakewood Perf-Slot- .125x66
270 to 300 & 320 to 460

License No #208

Topography:
☐ Hill
☒ Slope
☐ Upland
☐ Valley

17 Water well contractor's certification:
This well was drilled under my jurisdiction and this report is true to the best of my knowledge and belief.

K.I.Drilling #263
Business name License No.
Address Ulysses, Kansas 67880
Signed Bob Kuller Date 6/4/75
Authorized representative

Forward the white, blue and pink copies to the Kansas State Dept. Of Health.

Form WWC-5

677-H