


1 LOCATION OF WATER WELL: Fraction SW 1/4 SE 1/4 NE 1/4 Section Number 28 Township Number T 28 S Range Number R 35 EW  
 County: Grant  
 Distance and direction from nearest town or city street address of well if located within city?

2 WATER WELL OWNER: Galen Giesbrecht  
 RR#, St. Address, Box #: 1621 N. Road V Board of Agriculture, Division of Water Resources  
 City, State, ZIP Code: Ulysses, KS, 67880 Application Number:

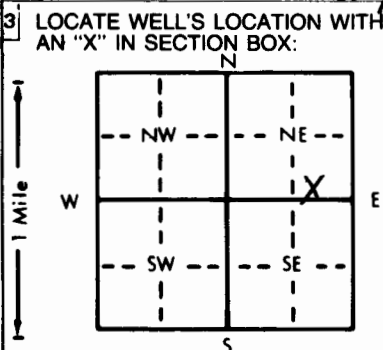

4 DEPTH OF COMPLETED WELL: 430 ft. ELEVATION: ..... ft.  
 Depth(s) Groundwater Encountered 1. 310 ft. 2. .... ft. 3. .... ft.  
 WELL'S STATIC WATER LEVEL 310 ft. below land surface measured on mo/day/yr 2/19/91  
 Pump test data: Well water was ..... ft. after ..... hours pumping ..... gpm  
 Est. Yield ..... gpm: Well water was ..... ft. after ..... hours pumping ..... gpm  
 Bore Hole Diameter ..... in. to ..... ft., and ..... in. to ..... ft.  
 WELL WATER TO BE USED AS:  
 1 Domestic was 3 Feedlot 6 Oil field water supply 9 Dewatering 12 Other (Specify below)  
2 Irrigation 4 Industrial 7 Lawn and garden only 10 Monitoring well  
 Was a chemical/bacteriological sample submitted to Department? Yes ..... No X .....; If yes, mo/day/yr sample was submitted  
 Water Well Disinfected? Yes ..... No

5 TYPE OF BLANK CASING USED:  
1 Steel 3 RMP (SR) 5 Wrought iron 8 Concrete tile CASING JOINTS: Glued ..... Clamped .....  
 2 PVC 4 ABS 6 Asbestos-Cement 9 Other (specify below) Welded .....  
 7 Fiberglass ..... Threaded .....  
 Blank casing diameter 16 in. to ..... ft., Dia ..... in. to ..... ft., Dia ..... in. to ..... ft.  
 Casing height above land surface 3 ft Below in., weight ..... lbs./ft. Wall thickness or gauge No. ....  
 TYPE OF SCREEN OR PERFORATION MATERIAL:  
 1 Steel 3 Stainless steel 5 Fiberglass 7 PVC 10 Asbestos-cement  
 2 Brass 4 Galvanized steel 6 Concrete tile 8 RMP (SR) 11 Other (specify) .....  
 9 ABS 12 None used (open hole)  
 SCREEN OR PERFORATION OPENINGS ARE:  
 1 Continuous slot 3 Mill slot 5 Gauzed wrapped 8 Saw cut 11 None (open hole)  
 2 Louvered shutter 4 Key punched 6 Wire wrapped 9 Drilled holes  
 7 Torch cut 10 Other (specify) .....  
 SCREEN-PERFORATED INTERVALS: From ..... ft. to ..... ft., From ..... ft. to ..... ft.  
 From ..... ft. to ..... ft., From ..... ft. to ..... ft.  
 GRAVEL PACK INTERVALS: From ..... ft. to ..... ft., From ..... ft. to ..... ft.  
 From ..... ft. to ..... ft., From ..... ft. to ..... ft.

6 GROUT MATERIAL: 1 Neat cement 2 Cement grout 3 Bentonite 4 Other .....  
 Grout Intervals: From 6 ft. to 3 ft., From ..... ft. to ..... ft., From ..... ft. to ..... ft.  
 What is the nearest source of possible contamination:  
 1 Septic tank 4 Lateral lines 7 Pit privy 10 Livestock pens 14 Abandoned water well  
 2 Sewer lines 5 Cess pool 8 Sewage lagoon 11 Fuel storage 15 Oil well Gas well  
 3 Watertight sewer lines 6 Seepage pit 9 Feedyard 12 Fertilizer storage 16 Other (specify below)  
 13 Insecticide storage .....  
 Direction from well? West How many feet? 1650

FROM	TO	LITHOLOGIC LOG	FROM	TO	PLUGGING INTERVALS
430	310	Closinated Sand & Gravel (1572 Cu. Ft)			
310	6	Clays (398.2 Cu. Ft)			
6	3	Cement Grout (3.9 Cu Ft)			

7 CONTRACTOR'S OR LANDOWNER'S CERTIFICATION: This water well was (1) constructed, (2) reconstructed, or (3) plugged under my jurisdiction and was completed on (mo/day/year) 2-16-91 and this record is true to the best of my knowledge and belief. Kansas Water Well Contractor's License No. .... This Water Well Record was completed on (mo/day/yr) 2-19-91 under the business name of ..... by (signature) Galen Giesbrecht