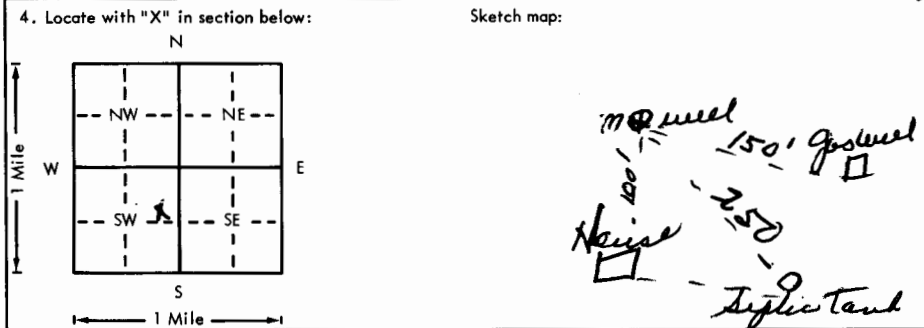


USE TYPEWRITER OR BALL POINT PEN-PRESS FIRMLY, PRINT CLEARLY.

WATER WELL RECORD
KSA 82a-1201-1215

Kansas Department of Health and Environment-Division of Environment (Water well Contractors) Topeka, Kansas 66620

1. Location of well:	County Grant	Fraction SE 1/4 NE 1/4 SW 1/4	Section number 36	Township number 28	Range number 35
2. Distance and direction from nearest town or city: 15 miles east of four way stop at Ulysses Street address of well location if in city:			3. Owner of well: Wilford A. Britton R.R. or street: 308 West Santa Fe City, state, zip code: Ulysses, Ks. 67880		
4. Locate with "X" in section below: 			6. Bore hole dia. 9 1/2 in. Completion date _____ Well depth 404 ft. 9/25/78		
5. Type and color of material			7. <input checked="" type="checkbox"/> Cable tool <input checked="" type="checkbox"/> Rotary <input type="checkbox"/> Driven <input type="checkbox"/> Dug <input type="checkbox"/> Hollow rod <input type="checkbox"/> Jetted <input type="checkbox"/> Bored <input type="checkbox"/> Reverse rotary		
Surface			8. Use: <input checked="" type="checkbox"/> Domestic <input type="checkbox"/> Public supply <input type="checkbox"/> Industry <input type="checkbox"/> Irrigation <input type="checkbox"/> Air conditioning <input type="checkbox"/> Stock <input type="checkbox"/> Lawn <input type="checkbox"/> Oil field water <input type="checkbox"/> Other		
Sandy clay			9. Casing: Material styrene Height Above or below glued and rivet Surface 14 in. RMP _____ PVC _____ Weight _____ lbs./ft. Dia. 5 in. to 354 ft. depth Wall Thickness: inches or Dia. _____ in. to _____ ft. depth gage No. 1.320		
Medium sand w/clay strips			10. Screen: Manufacturer's name _____ Sunflower Type Styrene Dia. 5" Slot/gauze 1/16" Length 50 Set between 354 ft. and 404 ft. _____ ft. and _____ ft. Gravel pack? <input checked="" type="checkbox"/> Size range of material 1/4"		
Coarse sand			11. Static water level: _____ mo./day/yr. 284 ft. below land surface Date 9-11-78		
Clay			12. Pumping level below land surfaces: 290 ft. after 5 hrs. pumping 20 g.p.m. _____ ft. after _____ hrs. pumping _____ g.p.m. Estimated maximum yield 50 g.p.m.		
Medium to coarse sand			13. Water sample submitted: _____ mo./day/yr. Yes <input type="checkbox"/> No <input checked="" type="checkbox"/> Date _____		
Fine to medium sand w/cemented clay breakers			14. Well head completion: <input checked="" type="checkbox"/> Pitless adapter 14 inches above grade		
Fine to medium sand			15. Well grouted? <input checked="" type="checkbox"/> With: <input checked="" type="checkbox"/> Neat cement <input type="checkbox"/> Bentonite <input type="checkbox"/> Concrete Depth: From 0 ft. to 10 ft.		
			16. Nearest source of possible contamination: ft. 250 Direction SE Type Septic tank Well disinfected upon completion? <input checked="" type="checkbox"/> Yes <input type="checkbox"/> No		
			17. Pump: <input checked="" type="checkbox"/> Not installed Manufacturer's name _____ Model number _____ HP _____ Volts _____ Length of drop pipe _____ ft. capacity _____ g.p.m. Type: <input type="checkbox"/> Submersible <input type="checkbox"/> Turbine <input type="checkbox"/> Jet <input type="checkbox"/> Reciprocating <input type="checkbox"/> Centrifugal <input type="checkbox"/> Other		
			20. Water well contractor's certification: This well was drilled under my jurisdiction and this report is true to the best of my knowledge and belief. Houck Bros. Drilling Co. 164 Business name _____ License No. _____ Address Box 487, Ulysses, Ks. Signed M. Beard Date 10/20/78 Authorized representative		
18. Elevation:		19. Remarks:			
Topography: <input type="checkbox"/> Hill <input checked="" type="checkbox"/> Slope <input type="checkbox"/> Upland <input type="checkbox"/> Valley					

T 28
 R 35
 E 36
 S 36
 SE 1/4
 SW 1/4