

# CORRECTED



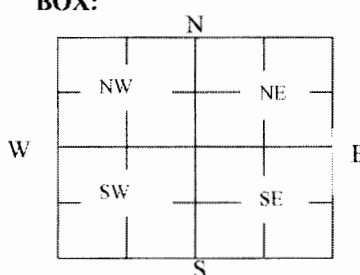
## WATER WELL PLUGGING RECORD Form WWC-5P

KSA 82a-12121268200

<b>1 LOCATION OF WATER WELL:</b> County: <b>Grant</b>	Fraction <b>NE 1/4 NE 1/4 NE 1/4 SE 1/4</b>	Section Number <b>7</b>	Township Number <b>28 T S</b>	Range Number <b>35</b> <input type="checkbox"/> E <input type="checkbox"/> W
--	--	----------------------------	----------------------------------	---

Street/Rural Address of Well Location; if unknown, distance & direction from nearest town or intersection: If at owner's address, check here <input checked="" type="checkbox"/>	<b>Global Positioning Systems (GPS) information:</b> Latitude: <b>37.62658</b> (in decimal degrees) Longitude: <b>101.182300</b> (in decimal degrees) Elevation: <b>3099</b> Datum: <input checked="" type="checkbox"/> WGS84, <input type="checkbox"/> NAD83, <input type="checkbox"/> NAD27 Collection Method: <input type="checkbox"/> GPS unit (Make/Model: _____) <input type="checkbox"/> Digital Map/Photo, <input type="checkbox"/> Topographic Map, <input type="checkbox"/> Land Survey Est. Accuracy: <input checked="" type="checkbox"/> < 3 m, <input type="checkbox"/> 3-5 m, <input type="checkbox"/> 5-15 m, <input type="checkbox"/> > 15 m
--	--

<b>2 WATER WELL OWNER: Gary Covey</b> RR#, St. Address, Box #: <b>P.O.Box845</b> City, State ZIP Code: <b>Ulysses ks 67880</b>
--

<b>3 MARK WELL'S LOCATION WITH AN "X" IN SECTION BOX:</b> 	<b>4 DEPTH OF WELL 398</b> ft. WELL'S STATIC WATER LEVEL <b>0</b> ft. WELL WAS USED AS: <input checked="" type="checkbox"/> Domestic <input type="checkbox"/> Public Water Supply <input type="checkbox"/> Dewatering <input type="checkbox"/> Irrigation <input type="checkbox"/> Oil Field Water Supply <input type="checkbox"/> Monitoring <input type="checkbox"/> Feedlot <input type="checkbox"/> Domestic (Lawn & Garden) <input type="checkbox"/> Injection Well <input type="checkbox"/> Industrial <input type="checkbox"/> Air Conditioning <input type="checkbox"/> Other _____ Was a chemical/bacteriological sample submitted to Department? Yes <input type="checkbox"/> No <input checked="" type="checkbox"/>
---	---

**5 TYPE OF BLANK CASING USED:**

Steel  RMP (SR)  Wrought  Fiberglass  Other (Specify below)  
 PVC  ABS  Asbestos-Cement  Concrete Tile

Blank casing diameter **5** in. Was casing pulled? Yes  No  If yes, how much **4feet**  
 Casing height above or below land surface **48** in.

**6 GROUT PLUG MATERIAL:**  Neat cement  Cement grout  Bentonite  Other \_\_\_\_\_

Grout Plug Intervals: From **5** ft. to **25** ft., From \_\_\_\_\_ ft. to \_\_\_\_\_ ft., From \_\_\_\_\_ ft. to \_\_\_\_\_ ft.

What is the nearest source of possible contamination:  
 Septic tank  Seepage pit  Fuel storage  Other (specify below)  
 Sewer lines  Pit privy  Fertilizer storage  
 Watertight sewer lines  Sewage lagoon  Insecticide storage  
 Lateral lines  Feedyard  Abandoned water well  Direction from well? **west**  
 Cess pool  Livestock pens  Oil well/Gas well  How many feet? **125**

FROM	TO	PLUGGING MATERIALS	FROM	TO	PLUGGING MATERIALS
0	5	top soil			
5	25	holeplug			
25	240	sand			
240	398	clorinated sand			
240	260	17-18 PLUG			
260	398	CLORANATED SAND			

**7 CONTRACTOR'S OR LANDOWNER'S CERTIFICATION:** This water well was plugged under my jurisdiction and was completed on (mo/day/year) **09/11/2015** and this record is true to the best of my knowledge and belief. Kansas Water Well Contractor's License No. **888**. This Water Well Record was completed on (mo/day/year) **10/04/2015** under the business name of **Steves Drilling** by (signature) \_\_\_\_\_