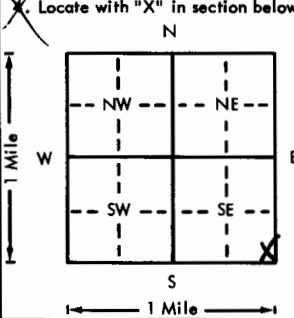
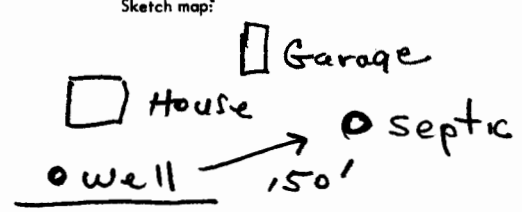


USE TYPEWRITER OR BALL POINT PEN—PRESS FIRMLY, PRINT CLEARLY.

WATER WELL RECORD
KSA 82a-1201-1215

Kansas Department of Health and Environment—Division of Environment
(Water well Contractors)
Topeka, Kansas 66620

1. Location of well: County Grant		Section SW 1/4 SE 1/4 SE 1/4		Section number 9		Township number T 28		Range number S R 36 E/W			
2. Distance and direction from nearest town or city: 4 mi East Novita				3. Owner of well: Winston Nightingale							
Street address of well location if in city: 1/2 E. of Ulysses, Ks				R.R. or street: Rt. #1							
				City, state, zip code: Ulysses, Ks. 67880							
X. Locate with "X" in section below: 				Sketch map: 				6. Bore hole dia. 4 3/8 in. Completion date 6-6-77		Well depth 435 ft.	
				7. Cable tool <input checked="" type="checkbox"/> Rotary <input type="checkbox"/> Driven <input type="checkbox"/> Dug <input type="checkbox"/> Hollow rod <input type="checkbox"/> Jetted <input type="checkbox"/> Bored <input type="checkbox"/> Reverse rotary							
				8. Use: <input checked="" type="checkbox"/> Domestic <input type="checkbox"/> Public supply <input type="checkbox"/> Industry <input type="checkbox"/> Irrigation <input type="checkbox"/> Air conditioning <input type="checkbox"/> Stock <input type="checkbox"/> Lawn <input type="checkbox"/> Oil field water <input type="checkbox"/> Other							
				9. Casing: Material Styro Height: Above or below Threaded <input type="checkbox"/> Welded <input checked="" type="checkbox"/> Surface 12" in. RMP <input type="checkbox"/> PVC <input type="checkbox"/> Weight <input type="checkbox"/> lbs./ft. Dia. 5 in. to 435 ft. depth Wall Thickness: <input type="checkbox"/> inches or Dia. <input type="checkbox"/> in. to <input type="checkbox"/> ft. depth gage No. 0.320							
5. Type and color of material				From		To		10. Screen: Manufacturer's name Sunflower			
Surface fine sand				0		20		Plastic 60			
Loam				20		60		Type Styro Dia. 5"			
Brown Clay				60		80		Slot/gauze 06 (1/16) Length 70			
Loam				80		100		Set between 325 ft. and 355 ft.			
Brown Clay				100		130		395 ft. and 435 ft.			
Blue Clay				120		280		Gravel pack? <input checked="" type="checkbox"/> Yes Size range of material 1/4 - 1/8			
Brown Clay & Sand 30%				280		300		11. Static water level: 275 ft. below land surface Date 6-6-77			
Brown Clay				300		330		12. Pumping level below land surfaces: N.A.			
Loam				330		355		____ ft. after ____ hrs. pumping ____ g.p.m.			
Brown Clay				355		380		____ ft. after ____ hrs. pumping ____ g.p.m.			
Fine Sand				380		400		Estimated maximum yield: ____ g.p.m.			
Coarse sand				400		435		13. Water sample submitted: N.A. mo./day/yr.			
								Yes <input type="checkbox"/> No <input type="checkbox"/> Date ____			
								14. Well head completion:			
								<input checked="" type="checkbox"/> Pitless adapter 12 inches above grade			
								15. Well grouted? <input checked="" type="checkbox"/> X			
								With: <input checked="" type="checkbox"/> Neat cement <input type="checkbox"/> Bentonite <input type="checkbox"/> Concrete			
								Depth: From 5 ft. to 20 ft.			
								16. Nearest source of possible contamination:			
								ft. 150 Direction E Type Septic Tank			
								Well disinfected upon completion? <input checked="" type="checkbox"/> Yes <input type="checkbox"/> No			
								17. Pump:			
								____ Not installed			
								Manufacturer's name Sears			
								Model number NA HP 3 Volts 230			
								Length of drop pipe ____ ft. capacity ____ g.p.m.			
								Type:			
								<input checked="" type="checkbox"/> Submersible <input type="checkbox"/> Turbine			
								<input type="checkbox"/> Jet <input type="checkbox"/> Reciprocating			
								<input type="checkbox"/> Centrifugal <input type="checkbox"/> Other			
18. Elevation: Flat		19. Remarks: Concrete slab to be installed by customer, Winston Nightingale		20. Water well contractor's certification:							
Topography: <input type="checkbox"/> Hill <input type="checkbox"/> Slope <input type="checkbox"/> Upland <input type="checkbox"/> Valley				This well was drilled under my jurisdiction and this report is true to the best of my knowledge and belief.							
				Maquer Dr. 1111g 255							
				Business name Ulysses, Ks. License No. ____							
				Address Ulysses, Ks.							
				Signed Maquer Dr. 1111g Date 6-7-77							
				Authorized representative W							

T 28 R 36 E W 9 Sec 9 1/4 1/4 1/4 S W S E S E

Forward the white, blue and pink copies to the Department of Health and Environment

Form WWC-5