


1 LOCATION OF WATER WELL: County: Grant Fraction SW 1/4 SE 1/4 SE 1/4 Section Number 30 Township Number T 28 S Range Number R 36 E/W

Distance and direction from nearest town or city street address of well if located within city?
2 3/4 miles east of Ulysses, Kansas

2 WATER WELL OWNER: Grant county RR#, St. Address, Box #: 108 S. Glenn Board of Agriculture, Division of Water Resources City, State, ZIP Code: Ulysses, Kansas 67880 Application Number:

3 LOCATE WELL'S LOCATION WITH AN "X" IN SECTION BOX:

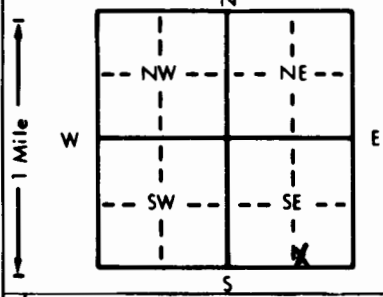

4 DEPTH OF COMPLETED WELL: 342 ft. ELEVATION: slope
Depth(s) Groundwater Encountered 1. 210 ft. 2. ft. 3. ft.
WELL'S STATIC WATER LEVEL: 210 ft. below land surface measured on mo/day/yr 4/12/94
Pump test data: Well water was 212 ft. after 6 hours pumping 10 gpm
Est. Yield 50 gpm: Well water was ft. after hours pumping gpm
Bore Hole Diameter 9.7/8 in. to 34.2 ft., and in. to ft.
WELL WATER TO BE USED AS:
5 Public water supply 8 Air conditioning 11 Injection well
Domestic 3 Feedlot 6 Oil field water supply 9 Dewatering 12 Other (Specify below)
2 Irrigation 4 Industrial 7 Lawn and garden only 10 Monitoring well
Was a chemical/bacteriological sample submitted to Department? Yes No X; If yes, mo/day/yr sample was submitted Water Well Disinfected? Yes X No

5 TYPE OF BLANK CASING USED:
1 Steel 3 RMP (SR) 5 Wrought iron 8 Concrete tile CASING JOINTS: Glued X Clamped
2 PVC 4 ABS 6 Asbestos-Cement 9 Other (specify below) & riveted Welded
7 Fiberglass Threaded

Blank casing diameter 5 in. to 28.2 ft., Dia. in. to ft., Dia. in. to ft.
Casing height above land surface 18 in., weight Schedule 200 lbs./ft. Wall thickness or gauge No.

TYPE OF SCREEN OR PERFORATION MATERIAL:
1 Steel 3 Stainless steel 5 Fiberglass 8 RMP (SR) 10 Asbestos-cement 11 Other (specify)
2 Brass 4 Galvanized steel 6 Concrete tile 9 ABS 12 None used (open hole)

SCREEN OR PERFORATION OPENINGS ARE:
1 Continuous slot 3 Mill slot 5 Gauzed wrapped 8 Saw cut 11 None (open hole)
2 Louvered shutter 4 Key punched 6 Wire wrapped 9 Drilled holes
7 Torch cut 10 Other (specify)

SCREEN-PERFORATED INTERVALS: From 282 ft. to 342 ft., From ft. to ft.
GRAVEL PACK INTERVALS: From 24 ft. to 34.2 ft., From ft. to ft.

6 GROUT MATERIAL: 1 Neat cement 2 Cement grout 3 Bentonite 4 Other
Grout Intervals: From 24 ft. to 34.2 ft., From ft. to ft., From ft. to ft.

What is the nearest source of possible contamination:
1 Septic tank 4 Lateral lines 7 Pit privy 10 Livestock pens 14 Abandoned water well
2 Sewer lines 5 Cess pool 8 Sewage lagoon 11 Fuel storage 15 Oil well/Gas well
3 Watertight sewer lines 6 Seepage pit 9 Feedyard 12 Fertilizer storage 16 Other (specify below)
Landfill
13 Insecticide storage

Direction from well? northwest How many feet? 300

FROM	TO	LITHOLOGIC LOG	FROM	TO	PLUGGING INTERVALS
0	2	Surface			
2	50	Sand w/clay strips			
50	115	Sandy clay			
115	190	Fine sand			
190	240	Blue and gray clay			
240	270	Brown clay			
270	318	Coarse sand w/clay breakers			
318	345	Medium to fine sand			
345	357	Fine red sand			

7 CONTRACTOR'S OR LANDOWNER'S CERTIFICATION: This water well was (1) constructed (2) reconstructed, or (3) plugged under my jurisdiction and was completed on (mo/day/year) 4-13-94 and this record is true to the best of my knowledge and belief. Kansas Water Well Contractor's License No. 164 This Water Well Record was completed on (mo/day/yr) 4-15-94 under the business name of Houck Bros. Drilling co. by (signature) M. Beard

INSTRUCTIONS: Use typewriter or ball point pen. PLEASE PRESS FIRMLY and PRINT clearly. Please fill in blanks, underline or circle the correct answers. Send top three copies to Kansas Department of Health and Environment, Bureau of Water, Topeka, Kansas 66620-0001. Telephone: 913-296-5545. Send one to WATER WELL OWNER and retain one for your records.