


1 LOCATION OF WATER WELL: Fraction NW 1/4 NE 1/4 NW 1/4 Section Number 18 Township Number T 28N S Range Number R 36W **EW**
 County: GRANT

Distance and direction from nearest town or city street address of well if located within city?
 FROM ULYSSES 3 NORTH, & 3 3/8 EAST INTO LOC.

2 WATER WELL OWNER: TODD RANDLE
 RR#, St. Address, Box #: P.O. BOX 665 Board of Agriculture, Division of Water Resources
 City, State, ZIP Code: ULYSSES, KS 67880 Application Number:

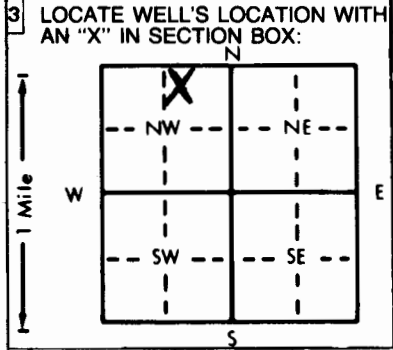

4 DEPTH OF COMPLETED WELL: 380 ft. ELEVATION:
 Depth(s) Groundwater Encountered 1. 200 ft. 2. ft. 3. ft.
 WELL'S STATIC WATER LEVEL: 200 ft. below land surface measured on mo/day/yr 10-20-94
 Pump test data: Well water was 220 ft. after 1 hours pumping 75 gpm
 Est. Yield 75 gpm: Well water was ft. after hours pumping gpm
 Bore Hole Diameter: 9 1/2 in. to 380 ft., and in. to ft.
 WELL WATER TO BE USED AS:
 1 Domestic 3 Feedlot 6 Oil field water supply 9 Dewatering 12 Other (Specify below)
 2 Irrigation 4 Industrial 7 Lawn and garden only 10 Monitoring well
 Was a chemical/bacteriological sample submitted to Department? Yes No X; If yes, mo/day/yr sample was submitted
 Water Well Disinfected? Yes X No

5 TYPE OF BLANK CASING USED:
 1 Steel 3 RMP (SR) 5 Wrought iron 6 Asbestos-Cement 8 Concrete tile 9 Other (specify below)
 2 PVC 4 ABS 7 Fiberglass
 Blank casing diameter .5 in. to 380 ft., Dia in. to ft., Dia in. to ft.
 Casing height above land surface .24 in., weight 2.902 lbs./ft. Wall thickness or gauge No. 265 SDR 21
 TYPE OF SCREEN OR PERFORATION MATERIAL:
 1 Steel 3 Stainless steel 5 Fiberglass 7 PVC 8 RMP (SR) 10 Asbestos-cement
 2 Brass 4 Galvanized steel 6 Concrete tile 9 ABS 11 Other (specify)
 12 None used (open hole)
 SCREEN OR PERFORATION OPENINGS ARE:
 1 Continuous slot 3 Mill slot 5 Gauzed wrapped 8 Saw cut 11 None (open hole)
 2 Louvered shutter 4 Key punched 6 Wire wrapped 9 Drilled holes
 7 Torch cut 10 Other (specify)
 SCREEN-PERFORATED INTERVALS: From 290 ft. to 380 ft., From ft. to ft.
 GRAVEL PACK INTERVALS: From 190 ft. to 380 ft., From ft. to ft.

6 GROUT MATERIAL: 1 Meat cement 2 Cement grout 3 Bentonite 4 Other HOLE PLUG
 Grout Intervals: From 1 ft. to 20 ft., From ft. to ft., From ft. to ft.
 What is the nearest source of possible contamination:
 1 Septic tank 4 Lateral lines 7 Pit privy 10 Livestock pens 14 Abandoned water well
 2 Sewer lines 5 Cess pool 8 Sewage lagoon 11 Fuel storage 15 Oil well/Gas well
 3 Watertight sewer lines 6 Seepage pit 9 Feedyard 12 Fertilizer storage 16 Other (specify below)
 13 Insecticide storage
 Direction from well? How many feet?

FROM	TO	LITHOLOGIC LOG	FROM	TO	PLUGGING INTERVALS
0	2	CLAY	194	219	BLUE CLAY
2	15	CALICHE CLAY	219	238	SAND
15	21	MED. GRAVEL	238	242	CLAY
21	35	CLAY	242	289	SAND
35	44	SAND	289	293	CLAY
44	82	CLAY	293	306	SANDY CLAY
82	135	BLUE CLAY	306	310	COARSE SAND
135	141	COARSE SAND	310	327	CLAY
141	162	BLUE CLAY	327	365	SAND
162	168	SAND	365	380	SAND, BLACK CLAY & BLUE SHALE
168	175	BLUE CLAY			
175	182	SAND			
182	185	BLUE CLAY			
185	188	SAND			
188	194	BLACK SANDY CLAY			

7 CONTRACTOR'S OR LANDOWNER'S CERTIFICATION: This water well was (1) constructed, (2) reconstructed, or (3) plugged under my jurisdiction and was completed on (mo/day/year) 10-20-94 and this record is true to the best of my knowledge and belief. Kansas Water Well Contractor's License No. KWWCL-430 This Water Well Record was completed on (mo/day/yr) 10-20-94 under the business name of HOWARD DRIG. CO. BOX 806 BEAVER, OK 73932 by (signature) *Alvin Howard*

INSTRUCTIONS: Use typewriter or ball point pen. PLEASE PRESS FIRMLY and PRINT clearly. Please fill in blanks, underline or circle the correct answers. Send top three copies to Kansas Department of Health and Environment, Bureau of Water, Topeka, Kansas 66620-0001. Telephone: 913-296-5545. Send one to WATER WELL OWNER and retain one for your records.