


1 LOCATION OF WATER WELL: County: GRANT Fraction: SE 1/4 SW 1/4 SW 1/4 Section Number: 27 Township Number: T 28 S Range Number: R 37 E/W

Distance and direction from nearest town or city street address of well if located within city?
320 West Oklahoma, Ulysses, Kansas MW 7

2 WATER WELL OWNER: Steve Tarbet
 RR#, St. Address, Box #: 320 West Oklahoma
 City, State, ZIP Code: Ulysses
 Board of Agriculture, Division of Water Resources
 Application Number:

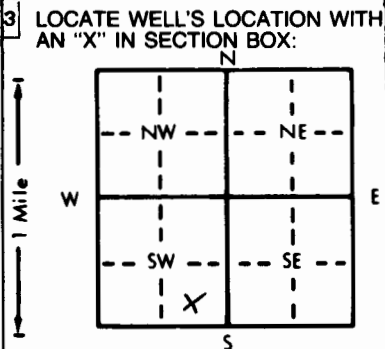

4 DEPTH OF COMPLETED WELL: 89 ft. ELEVATION:
 Depth(s) Groundwater Encountered 1. 81.5 ft. 2. 81.5 ft. 3. 81.5 ft.
 WELL'S STATIC WATER LEVEL: 78.4 ft. below land surface measured on mo/day/yr 8/3/95
 Pump test data: Well water was _____ ft. after _____ hours pumping _____ gpm
 Est. Yield _____ gpm: Well water was _____ ft. after _____ hours pumping _____ gpm
 Bore Hole Diameter: 8.625 in. to 89 ft., and _____ in. to _____ ft.
 WELL WATER TO BE USED AS:
 1 Domestic 3 Feedlot 6 Oil field water supply 9 Dewatering 12 Other (Specify below)
 2 Irrigation 4 Industrial 7 Lawn and garden only 10 Monitoring well
 Was a chemical/bacteriological sample submitted to Department? Yes No; If yes, mo/day/yr sample was submitted _____
 Water Well Disinfected? Yes No

5 TYPE OF BLANK CASING USED:
 1 Steel 3 RMP (SR) 5 Wrought iron 8 Concrete tile CASING JOINTS: Glued _____ Clamped _____
2 PVC 4 ABS 7 Fiberglass _____ Threaded
 Blank casing diameter 2 in. to _____ ft., Dia _____ in. to _____ ft., Dia _____ in. to _____ ft.
 Casing height above land surface: Flush in., weight 0.70 lbs./ft. Wall thickness or gauge No. Sch 40
 TYPE OF SCREEN OR PERFORATION MATERIAL:
 1 Steel 3 Stainless steel 5 Fiberglass 8 RMP (SR) 10 Asbestos-cement
 2 Brass 4 Galvanized steel 6 Concrete tile 9 ABS 11 Other (specify) _____
 12 None used (open hole)
 SCREEN OR PERFORATION OPENINGS ARE:
 1 Continuous slot 3 Mill slot 5 Gauzed wrapped 8 Saw cut 11 None (open hole)
 2 Louvered shutter 4 Key punched 6 Wire wrapped 9 Drilled holes
 7 Torch cut 10 Other (specify) _____
 SCREEN-PERFORATED INTERVALS: From 64 ft. to 89 ft., From _____ ft. to _____ ft.
 From _____ ft. to _____ ft., From _____ ft. to _____ ft.
 GRAVEL PACK INTERVALS: From 62 ft. to 89 ft., From _____ ft. to _____ ft.
 From _____ ft. to _____ ft., From _____ ft. to _____ ft.

6 GROUT MATERIAL: 1 Neat cement 2 Cement grout 3 Bentonite 4 Other _____
 Grout Intervals: From surface ft. to 60 ft., From 60 ft. to 62 ft., From _____ ft. to _____ ft.
 What is the nearest source of possible contamination:
 1 Septic tank 4 Lateral lines 7 Pit privy 10 Livestock pens 14 Abandoned water well
 2 Sewer lines 5 Cess pool 8 Sewage lagoon 11 Fuel storage 15 Oil well/Gas well
 3 Watertight sewer lines 6 Seepage pit 9 Feedyard 12 Fertilizer storage 16 Other (specify below) _____
 13 Insecticide storage _____
 Direction from well? _____ How many feet? _____

FROM	TO	LITHOLOGIC LOG	FROM	TO	PLUGGING INTERVALS
0	2.1	Sand + Gravel Fill	81	81.5	Sand from test, med grain
2.1	15	Silt, L. brown, moist & loose			moist, well graded & sub rnd
25	30	Silt L. brown to tan, damp & loose w/ stringer of fn sd, calcium throughout	81.5	92	4/A
45	49	Silt stone, tan poorly con w/ calcium carbonate, dry & hard to drill			
49	56	Sand L. brn, fn gr, loose and poorly graded, sub rnd & moist			
56	70	Silt, L. brown, moist & loose w/ thin layers (.2') thick fine sd.			
70	71.5	Sand, tan to grey, med grain, loose gtzic, well graded, sub rnd, moist			
71.5	80	Sandy, clayey silt, brown, moist and soft			
80	81	Clayey silt, L. olive green & moist			

7 CONTRACTOR'S OR LANDOWNER'S CERTIFICATION: This water well was (1) constructed, (2) reconstructed, or (3) plugged under my jurisdiction and was completed on (mo/day/year) 7/23/95 and this record is true to the best of my knowledge and belief. Kansas Water Well Contractor's License No. 589. This Water Well Record was completed on (mo/day/yr) 8/16/95 under the business name of MAXIM TECHNOLOGIES by (signature) William J. Purdon