


1 LOCATION OF WATER WELL: County: Grant Fraction: SE 1/4 SW 1/4 SW 1/4 Section Number: 27 Township Number: T 28 S Range Number: R 37 E
 Distance and direction from nearest town or city street address of well if located within city?
320 West Oklahoma, Ulysses KS, MW-6

2 WATER WELL OWNER: Steve Tarbet
 RR#, St. Address, Box #: 320 West Oklahoma Board of Agriculture, Division of Water Resources
 City, State, ZIP Code: Ulysses Kansas Application Number:

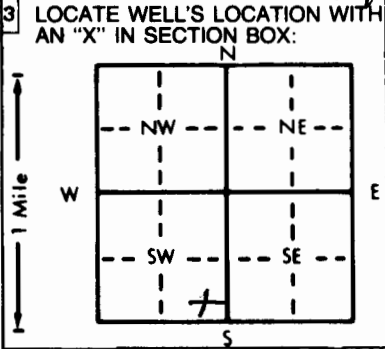

4 DEPTH OF COMPLETED WELL: 92 ft. ELEVATION:
 Depth(s) Groundwater Encountered 1. 78.6 ft. 2. ft. 3. ft.
 WELL'S STATIC WATER LEVEL 78.6 ft. below land surface measured on mo/day/yr 7/18/95
 Pump test data: Well water was ft. after hours pumping gpm
 Est. Yield gpm: Well water was ft. after hours pumping gpm
 Bore Hole Diameter 8.6 in. to 9.2 ft., and in. to ft.
 WELL WATER TO BE USED AS:
 1 Domestic 3 Feedlot 6 Oil field water supply 9 Dewatering 12 Other (Specify below)
 2 Irrigation 4 Industrial 7 Lawn and garden only 10 Monitoring well
 Was a chemical/bacteriological sample submitted to Department? Yes No; If yes, mo/day/yr sample was submitted
 Water Well Disinfected? Yes No

5 TYPE OF BLANK CASING USED:
 1 Steel 3 RMP (SR) 5 Wrought iron 8 Concrete tile CASING JOINTS: Glued Clamped
2 PVC 4 ABS 6 Asbestos-Cement 9 Other (specify below) Welded
 7 Fiberglass Threaded
 Blank casing diameter 2 in. to 6.7 ft., Dia. in. to ft., Dia. in. to ft.
 Casing height above land surface Flush Mount in., weight 0.70 lbs./ft. Wall thickness or gauge No. sch 40
 TYPE OF SCREEN OR PERFORATION MATERIAL:
 1 Steel 3 Stainless steel 5 Fiberglass 8 RMP (SR) 10 Asbestos-cement
 2 Brass 4 Galvanized steel 6 Concrete tile 9 ABS 11 Other (specify)
 12 None used (open hole)
 SCREEN OR PERFORATION OPENINGS ARE:
 1 Continuous slot 3 Mill slot 5 Gauzed wrapped 8 Saw cut 11 None (open hole)
 2 Louvered shutter 4 Key punched 6 Wire wrapped 9 Drilled holes
 7 Torch cut 10 Other (specify)
 SCREEN-PERFORATED INTERVALS: From 6.7 ft. to 9.2 ft., From ft. to ft.
 From ft. to ft., From ft. to ft.
 GRAVEL PACK INTERVALS: From 6.5 ft. to 9.2 ft., From ft. to ft.
 From ft. to ft., From ft. to ft.

6 GROUT MATERIAL: 1 Neat cement 2 Cement grout 3 Bentonite 4 Other
 Grout Intervals: From Surface 6.3 ft., From 6.3 ft. to 6.5 ft., From ft. to ft.
 What is the nearest source of possible contamination:
 1 Septic tank 4 Lateral lines 7 Pit privy 10 Livestock pens 14 Abandoned water well
 2 Sewer lines 5 Cess pool 8 Sewage lagoon 11 Fuel storage 15 Oil well/Gas well
 3 Watertight sewer lines 6 Seepage pit 9 Feedyard 12 Fertilizer storage 16 Other (specify below)
 13 Insecticide storage
 Direction from well? How many feet?

FROM	TO	LITHOLOGIC LOG	FROM	TO	PLUGGING INTERVALS
0	2.5	Sand + Gravel fill			
2.5	10.0	Silt, grey brown			
10	17.0	Silt L. brown			
17	25	Sand, tan v. fine grain			
25	50	Clay + Silt			
50	58	Sand, tan v. fine			
58	62	Sand, tan, fine to med gr.			
62	70	A/A			
70	75	A/A			
75	78	Sand, tan, fine grain			
78	93	A/A			

7 CONTRACTOR'S OR LANDOWNER'S CERTIFICATION: This water well was (1) constructed, (2) reconstructed, or (3) plugged under my jurisdiction and was completed on (mo/day/year) 7/18/95 and this record is true to the best of my knowledge and belief. Kansas Water Well Contractor's License No. 589 This Water Well Record was completed on (mo/day/yr) 8/16/95 under the business name of Maxim Technologies by (signature) William J. Purdon