


1 LOCATION OF WATER WELL: Fraction SE 1/4 SW 1/4 SW 1/4 Section Number 27 Township Number T 28 S Range Number R 37 E
 County: Grant

Distance and direction from nearest town or city street address of well if located within city?
320 West Oklahoma, Ulysses Kansas MW-5

2 WATER WELL OWNER: Steve Tarbet
 RR#, St. Address, Box #: 320 West Oklahoma Board of Agriculture, Division of Water Resources
 City, State, ZIP Code: Ulysses Kansas Application Number:

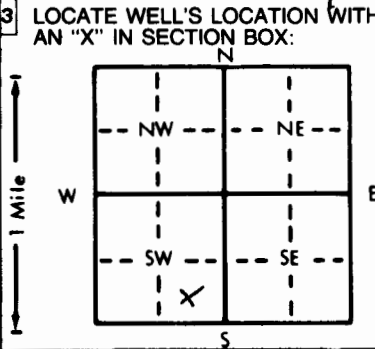

4 DEPTH OF COMPLETED WELL: 9.3 ft. ELEVATION:
 Depth(s) Groundwater Encountered 1. 8.2 ft. 2. ft. 3. ft.
 WELL'S STATIC WATER LEVEL: 81.8 ft. below land surface measured on mo/day/yr 8/3/95
 Pump test data: Well water was ft. after hours pumping gpm
 Est. Yield gpm: Well water was ft. after hours pumping gpm
 Bore Hole Diameter: 8.6 in. to 9.3 ft., and in. to ft.
 WELL WATER TO BE USED AS:
 5 Public water supply 8 Air conditioning 11 Injection well
 1 Domestic 3 Feedlot 6 Oil field water supply 9 Dewatering 12 Other (Specify below)
 2 Irrigation 4 Industrial 7 Lawn and garden only 10 Monitoring well
 Was a chemical/bacteriological sample submitted to Department? Yes No; If yes, mo/day/yr sample was submitted
 Water Well Disinfected? Yes No

5 TYPE OF BLANK CASING USED:
 1 Steel 3 RMP (SR) 5 Wrought iron 8 Concrete tile CASING JOINTS: Glued Clamped
2 PVC 4 ABS 6 Asbestos-Cement 9 Other (specify below) Welded
 7 Fiberglass Threaded
 Blank casing diameter 2 in. to ft., Dia. in. to ft., Dia. in. to ft.
 Casing height above land surface: Flush mount in., weight 0.7 lbs./ft. Wall thickness or gauge No. Sch. 40
 TYPE OF SCREEN OR PERFORATION MATERIAL:
 1 Steel 3 Stainless steel 5 Fiberglass 8 RMP (SR) 10 Asbestos-cement
 2 Brass 4 Galvanized steel 6 Concrete tile 9 ABS 11 Other (specify)
 12 None used (open hole)
 SCREEN OR PERFORATION OPENINGS ARE:
 1 Continuous slot 3 Mill slot 5 Gauzed wrapped 8 Saw cut 11 None (open hole)
 2 Louvered shutter 4 Key punched 6 Wire wrapped 9 Drilled holes
 7 Torch cut 10 Other (specify)
 SCREEN-PERFORATED INTERVALS: From 6.8 ft. to 9.3 ft., From ft. to ft.
 From ft. to ft., From ft. to ft.
 GRAVEL PACK INTERVALS: From 6.6 ft. to 9.3 ft., From ft. to ft.
 From ft. to ft., From ft. to ft.

6 GROUT MATERIAL: 1 Neat cement 2 Cement grout 3 Bentonite 4 Other
 Grout Intervals: From Surface ft. to 6.4 ft., From 6.4 ft. to 6.4 ft., From 6.4 ft. to 6.4 ft., From ft. to ft.
 What is the nearest source of possible contamination:
 1 Septic tank 4 Lateral lines 7 Pit privy 10 Livestock pens 14 Abandoned water well
 2 Sewer lines 5 Cess pool 8 Sewage lagoon 11 Fuel storage 15 Oil well/Gas well
 3 Watertight sewer lines 6 Seepage pit 9 Feedyard 12 Fertilizer storage 16 Other (specify below)
 13 Insecticide storage
 Direction from well? How many feet?

FROM		TO		LITHOLOGIC LOG	FROM	TO	PLUGGING INTERVALS
0	2.3	V.D brn silty clay-top soil					abn rust streak & rust color
2.3	20	D brn silty clay damp, non plastic					with mottling
20	25	clayey silt & brown w/ buff streaks damp & Loose	80	85			Sand L. brn, wet, fine gr., well graded, sub ang to sub rnd.
25	35	L. brn sandy silt damp & tight sand w/tn grain	85	96.1			Sand coarse, L. brn, loose, well graded, sub ang to sub rnd, tr feldspar & coal
35	40	A/A w/ trace amounts of clay and caliche	86.1	87			Sand L. brn, wet, fine gr., loose well graded
40	60	silt L. brn, damp, hard & tight	87	95			A/A
60	70	Sand tan to L. brown, quartz loose, damp, w/tn grain to med grain, sub rnd, well graded, tr coal & feldspar					
70	80	clayey silty to w/tn sand, moist stiff sli plastic, material had					

7 CONTRACTOR'S OR LANDOWNER'S CERTIFICATION: This water well was (1) constructed, (2) reconstructed, or (3) plugged under my jurisdiction and was completed on (mo/day/year) 8/16/95 and this record is true to the best of my knowledge and belief. Kansas Water Well Contractor's License No. 589 This Water Well Record was completed on (mo/day/yr) 8/16/95 under the business name of MAXIM TECHNOLOGIES by (signature) William J Purdon

INSTRUCTIONS: Use typewriter or ball point pen. PLEASE PRESS FIRMLY and PRINT clearly. Please fill in blanks, underline or circle the correct answers. Send top three copies to Kansas Department of Health and Environment, Bureau of Water, Topeka, Kansas 66620-0001. Telephone: 913-296-5545. Send one to WATER WELL OWNER and retain one for your records.