


1 LOCATION OF WATER WELL: County: Grant Fraction: SE 1/4 SW 1/4 SW 1/4 Section Number: 27 Township Number: T 28 S Range Number: R 37 E

Distance and direction from nearest town or city street address of well if located within city?
320 West Oklahoma, Ulysses Kansas mw-4

2 WATER WELL OWNER: Steve Tarbet
 RR#, St. Address, Box #: 320 West Oklahoma Board of Agriculture, Division of Water Resources
 City, State, ZIP Code: Ulysses, Kansas Application Number:

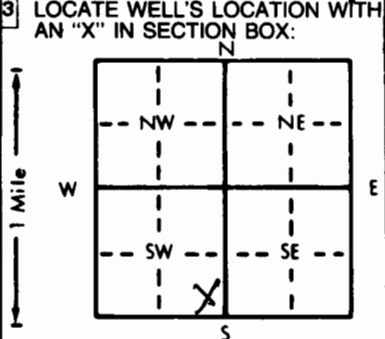

4 DEPTH OF COMPLETED WELL: 95 ft. ELEVATION:
 Depth(s) Groundwater Encountered 1. 81.4 ft. 2. ft. 3. ft.
 WELL'S STATIC WATER LEVEL: 81.4 ft. below land surface measured on mo/day/yr
 Pump test data: Well water was ft. after hours pumping gpm
 Est. Yield gpm: Well water was ft. after hours pumping gpm
 Bore Hole Diameter: 8.25 in. to 9.5 ft., and in. to ft.
 WELL WATER TO BE USED AS:
 1 Domestic 3 Feedlot 6 Oil field water supply 9 Dewatering 12 Other (Specify below)
 2 Irrigation 4 Industrial 7 Lawn and garden only 10 Monitoring well
 Was a chemical/bacteriological sample submitted to Department? Yes No X; If yes, mo/day/yr sample was submitted
 Water Well Disinfected? Yes No

5 TYPE OF BLANK CASING USED:
 1 Steel 3 RMP (SR) 5 Wrought iron 8 Concrete tile CASING JOINTS: Glued Clamped
2 PVC 4 ABS 6 Asbestos-Cement 9 Other (specify below) Welded
 Blank casing diameter: 2 in. to 7.0 ft., Dia. in. to ft., Dia. in. to ft.
 Casing height above land surface: Flush Mount in., weight: 0.70 lbs./ft. Wall thickness or gauge No. Sch 40
 TYPE OF SCREEN OR PERFORATION MATERIAL:
 1 Steel 3 Stainless steel 5 Fiberglass 8 RMP (SR) 10 Asbestos-cement
 2 Brass 4 Galvanized steel 6 Concrete tile 9 ABS 11 Other (specify)
 12 None used (open hole)
 SCREEN OR PERFORATION OPENINGS ARE:
 1 Continuous slot 3 Mill slot 5 Gauzed wrapped 8 Saw cut 11 None (open hole)
 2 Louvered shutter 4 Key punched 6 Wire wrapped 9 Drilled holes
 7 Torch cut 10 Other (specify)
 SCREEN-PERFORATED INTERVALS: From 7.0 ft. to 9.5 ft., From ft. to ft.
 From 6.6 ft. to 9.5 ft., From ft. to ft.
 GRAVEL PACK INTERVALS: From 6.6 ft. to 9.5 ft., From ft. to ft.
 From ft. to ft., From ft. to ft.

6 GROUT MATERIAL: 1 Neat cement 2 Cement grout 3 Bentonite 4 Other
 Grout Intervals: From 1.5 to 6.3 ft., From 6.3 to 6.6 ft., From ft. to ft.
 What is the nearest source of possible contamination:
 1 Septic tank 4 Lateral lines 7 Pit privy 10 Livestock pens 14 Abandoned water well
 2 Sewer lines 5 Cess pool 8 Sewage lagoon 11 Fuel storage 15 Oil well/Gas well
 3 Watertight sewer lines 6 Seepage pit 9 Feedyard 12 Fertilizer storage 16 Other (specify below)
 13 Insecticide storage

Direction from well? How many feet? Lithologic description

| FROM | TO | LITHOLOGIC LOG | FROM | TO | PLUGGING INTERVALS |
|------|------|--|------|------|--|
| 0 | 2.1 | Sand & gravel fill + topsoil | | | sub rnd, moist loose damp |
| 2.1 | 15 | silty clay, brn, damp soft | 80.0 | 85.0 | Sand tan to grey, fn gr, sub |
| 15.0 | 20.0 | clayey silt, damp, brn, soft, loose | | | rnd to sub ang, moist to wet. Loose |
| 20.0 | 25.0 | clay silt, L. brn, mottled buff, damp soft & loose | 86.7 | 87 | clayey in part w/ tan clay seams |
| 25.0 | 40.0 | silty, L. brn, damp, loose, tr. clay | 87.0 | 95.0 | Sand dk grey (stained) med to fine grain, well graded, Loose wet |
| 40.0 | 45.0 | A/A w/increase in clay content thin seams, 1" thick | | | A/A |
| 45.0 | 50.0 | silty clay, buff to tan color, damp med stiff, sl. plastic | | | |
| 50.0 | 60.0 | silt, L brn, damp, Loose | | | |
| 60.0 | 70.0 | Sand tan, med grain, sub rnd well sorted (poorly graded) damp trace coal | | | |
| 70.0 | 80.0 | Sand, tan to grey, v-fn, sub ang to | | | |

7 CONTRACTOR'S OR LANDOWNER'S CERTIFICATION: This water well was (1) constructed (2) reconstructed, or (3) plugged under my jurisdiction and was completed on (mo/day/year) 6/3/95 and this record is true to the best of my knowledge and belief. Kansas Water Well Contractor's License No. 589 This Water Well Record was completed on (mo/day/yr) 8/16/95 under the business name of MAXIM TECHNOLOGIES by (signature)

INSTRUCTIONS: Use typewriter or ball point pen. PLEASE PRESS FIRMLY and PRINT clearly. Please fill in blanks, underline or circle the correct answers. Send top three copies to Kansas Department of Health and Environment, Bureau of Water, Topeka, Kansas 66620-0001. Telephone: 913-296-5545. Send one to WATER WELL OWNER and retain one for your records.