


1 LOCATION OF WATER WELL: County: Grant Fraction: SE 1/4 SW 1/4 SW 1/4 Section Number: 27 Township Number: T 28 S Range Number: R 37 E (W)

Distance and direction from nearest town or city street address of well if located within city?
320 West Oklahoma, Ulysses KS MW-3

2 WATER WELL OWNER: Steve Tarbet
 RR#, St. Address, Box #: 320 West Oklahoma Board of Agriculture, Division of Water Resources
 City, State, ZIP Code: Ulysses Kansas Application Number:

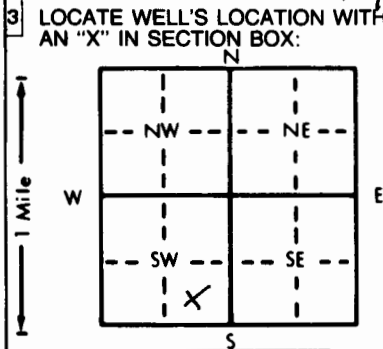

4 DEPTH OF COMPLETED WELL: 90 FT. ft. ELEVATION: ft.
 Depth(s) Groundwater Encountered 1. 82 ft. 2. ft. 3. ft.
 WELL'S STATIC WATER LEVEL: 80.2 ft. below land surface measured on mo/day/yr 6-1-95
 Pump test data: Well water was ft. after hours pumping gpm
 Est. Yield gpm: Well water was ft. after hours pumping gpm
 Bore Hole Diameter: 8.25 in. to 90 ft., and in. to ft.
 WELL WATER TO BE USED AS:
 5 Public water supply 8 Air conditioning 11 Injection well
 1 Domestic 3 Feedlot 6 Oil field water supply 9 Dewatering 12 Other (Specify below)
 2 Irrigation 4 Industrial 7 Lawn and garden only 10 Monitoring well
 Was a chemical/bacteriological sample submitted to Department? Yes..... No ; If yes, mo/day/yr sample was sub-
 mitted Water Well Disinfected? Yes No

5 TYPE OF BLANK CASING USED:
 1 Steel 2 PVC 3 RMP (SR) 4 ABS 5 Wrought iron 6 Asbestos-Cement 7 Fiberglass 8 Concrete tile 9 Other (specify below) CASING JOINTS: Glued Clamped
 Blank casing diameter 2 in. to 90 ft., Dia. in. to ft., Dia. in. to ft. Welded
 Casing height above land surface: flush mount in., weight 7 lbs./ft. Wall thickness or gauge No. Sch 40 Threaded:
 TYPE OF SCREEN OR PERFORATION MATERIAL:
 1 Steel 2 Brass 3 Stainless steel 4 Galvanized steel 5 Fiberglass 6 Concrete tile 7 PVC 7 PVC 8 RMP (SR) 9 ABS 10 Asbestos-cement 11 Other (specify) 12 None used (open hole)
 SCREEN OR PERFORATION OPENINGS ARE:
 1 Continuous slot 2 Louvered shutter 3 Mill slot 3 Mill slot 4 Key punched 5 Gauzed wrapped 6 Wire wrapped 7 Torch cut 8 Saw cut 9 Drilled holes 11 None (open hole) 12 Other (specify)
 SCREEN-PERFORATED INTERVALS: From 65 ft. to 90 ft., From ft. to ft.
 GRAVEL PACK INTERVALS: From 63 ft. to 90 ft., From ft. to ft.

6 GROUT MATERIAL: 1 Neat cement 2 Cement grout 2 Cement grout 3 Bentonite 4 Other
 Grout Intervals: From 5 ft. to 63 ft., From 61 ft. to 63 ft., From ft. to ft.
 What is the nearest source of possible contamination:
 1 Septic tank 2 Sewer lines 3 Watertight sewer lines 4 Lateral lines 5 Cess pool 6 Seepage pit 7 Pit privy 8 Sewage lagoon 9 Feedyard 10 Livestock pens 11 Fuel storage 11 Fuel storage 12 Fertilizer storage 13 Insecticide storage 14 Abandoned water well 15 Oil well/Gas well 16 Other (specify below)
 Direction from well? How many feet? Lithologic Description

FROM	TO	LITHOLOGIC LOG	FROM	TO	PLUGGING INTERVALS
0	1.5	0. brn silty clay (topsoil)			
1.5	20.0	Silty, brn, damp, loose, tr clay	80.0	90.0	well graded, loose, tr. feldspar
20.0	25.0	silty clay, damp, L. brn w/ buff streaks, stiff, silty plastic			Sand L. brn to olive grey (staining) fine to coarse, sub rnd to sub ang, well graded (poorly sorted loose wet).
25.0	35.0	silt, brn w/ buff streak, damp, loose			
35.0	40.0	silty sand, L. brn, damp, loose - sd v fn gr, sub ang to sub rnd	92.0	95.0	Clay L. brown, moist, hard & plastic
40.0	45.0	clay, tan, damp, hard, silty plastic	95.0	97.0	Clay L. brn, mottled, rust, moist hard & plastic
45.0	50.0	clay silty, tan damp, med, stiff slightly plastic			
50.0	60.0	Silt, tan, damp, loose.			
60.0	70.0	sand tan color, med to fn grn, damp well, rnd, loose, well graded			
70.0	80	Sand, light brn, damp, v fn grain well rnd to sub ang, trace coal?			

7 CONTRACTOR'S OR LANDOWNER'S CERTIFICATION: This water well was (1) constructed, (2) reconstructed, or (3) plugged under my jurisdiction and was completed on (mo/day/year) 6/1/95 and this record is true to the best of my knowledge and belief. Kansas Water Well Contractor's License No. 589 This Water Well Record was completed on (mo/day/yr) 6/16/95 under the business name of Huntingdon Eng + Env (MAXIM TECHNOLOGY) (signature) William J. Puchon