


1 LOCATION OF WATER WELL: County: GRANT Fraction: SE 1/4 SW 1/4 SW 1/4 Section Number: 27 Township Number: T 28 S Range Number: R 37 E

Distance and direction from nearest town or city street address of well if located within city? 320 West Oklahoma Kansas TARBET MW-1

2 WATER WELL OWNER: Steve Tarbet
 RR#, St. Address, Box #: 320 West Oklahoma
 City, State, ZIP Code: Ulysses Kansas
 Board of Agriculture, Division of Water Resources
 Application Number:

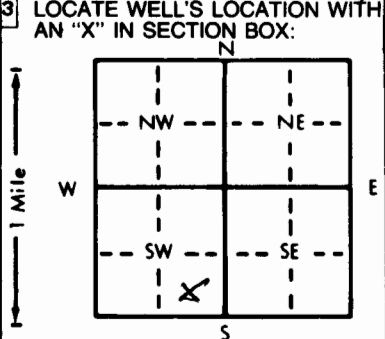

4 DEPTH OF COMPLETED WELL: 94 ft. ELEVATION:
 Depth(s) Groundwater Encountered 1. 81.9 ft. 2. ft. 3. ft.
 WELL'S STATIC WATER LEVEL: 81.9 ft. below land surface measured on mo/day/yr 5/26/95
 Pump test data: Well water was ft. after hours pumping gpm
 Est. Yield gpm: Well water was ft. after hours pumping gpm
 Bore Hole Diameter: 8.6 in. to 9.4 ft., and in. to ft.
 WELL WATER TO BE USED AS:
 5 Public water supply 8 Air conditioning 11 Injection well
 1 Domestic 3 Feedlot 6 Oil field water supply 9 Dewatering 12 Other (Specify below)
 2 Irrigation 4 Industrial 7 Lawn and garden only 10 Monitoring well
 Was a chemical/bacteriological sample submitted to Department? Yes No; If yes, mo/day/yr sample was submitted
 Water Well Disinfected? Yes No

5 TYPE OF BLANK CASING USED:
 1 Steel 3 RMP (SR) 5 Wrought iron 8 Concrete tile CASING JOINTS: Glued Clamped
2 PVC 4 ABS 7 Fiberglass Threaded
 Blank casing diameter 2 in. to ft., Dia. in. to ft., Dia. in. to ft.
 Casing height above land surface: Flush in., weight 0.70 lbs./ft. Wall thickness or gauge No. Sch 40
 TYPE OF SCREEN OR PERFORATION MATERIAL:
 1 Steel 3 Stainless steel 5 Fiberglass 7 PVC 10 Asbestos-cement
 2 Brass 4 Galvanized steel 6 Concrete tile 9 ABS 11 Other (specify)
 12 None used (open hole)
 SCREEN OR PERFORATION OPENINGS ARE:
 1 Continuous slot 3 Mill slot 5 Gauzed wrapped 8 Saw cut 11 None (open hole)
 2 Louvered shutter 4 Key punched 6 Wire wrapped 9 Drilled holes
 7 Torch cut 10 Other (specify)
 SCREEN-PERFORATED INTERVALS: From 94 ft. to 64 ft., From ft. to ft.
 From ft. to ft., From ft. to ft.
 GRAVEL PACK INTERVALS: From 94 ft. to 62 ft., From ft. to ft.
 From ft. to ft., From ft. to ft.

6 GROUT MATERIAL: 1 Neat cement 2 Cement grout 3 Bentonite 4 Other
 Grout Intervals: From 62 to 60 ft., From 62 to 62 ft., From ft. to ft.
 What is the nearest source of possible contamination:
 1 Septic tank 4 Lateral lines 7 Pit privy 10 Livestock pens 14 Abandoned water well
 2 Sewer lines 5 Cess pool 8 Sewage lagoon 11 Fuel storage 15 Oil well/Gas well
 3 Watertight sewer lines 6 Seepage pit 9 Feedyard 12 Fertilizer storage 16 Other (specify below)
 13 Insecticide storage
 Direction from well? How many feet?

FROM	TO	LITHOLOGIC LOG	FROM	TO	PLUGGING INTERVALS
0	0.5	Topsoil			
0.5	10	silt, pale brown damp, loose (f. #1)			
10	25	silty clay, soft, low plasticity, pale brown damp			
25	30	silt, buff color, damp loose			
30	35	silt w/ v. fn sand, buff damp			
35	40	silt soft, buff color damp			
40	45	clayey silt sli plastic, soft buff, damp			
45	50	silt, buff, damp, tr vfn sd			
50	60	clayey silt light brn w/ buff specs damp			
60	70	sand tan, med gr sub ang-well rpd well graded			
70	72	clayey silt, grey w/ buff mottling stiff & plastic			
72	82	sand orange-brn, moist, fn gr, poorly graded			
82	94	A/A			

7 CONTRACTOR'S OR LANDOWNER'S CERTIFICATION: This water well was (1) constructed (2) reconstructed, or (3) plugged under my jurisdiction and was completed on (mo/day/year) 5/26/94 and this record is true to the best of my knowledge and belief. Kansas Water Well Contractor's License No. 589 This Water Well Record was completed on (mo/day/yr) 8/16/95 under the business name of Maxim Technologies by (signature) William J. Lardon

INSTRUCTIONS: Use typewriter or ball point pen. PLEASE PRESS FIRMLY and PRINT clearly. Please fill in blanks, underline or circle the correct answers. Send top three copies to Kansas Department of Health and Environment, Bureau of Water, Topeka, Kansas 66620-0001. Telephone: 913-296-5545. Send one to WATER WELL OWNER and retain one for your records.