


1 LOCATION OF WATER WELL: County: Grant Fraction: SE 1/4 SW 1/4 SW 1/4 Section Number: 27 Township Number: T 28 S Range Number: R 37 E EW

Distance and direction from nearest town or city street address of well if located within city?
320 West Oklahoma Ave MW-2

2 WATER WELL OWNER: RR#, St. Address, Box #: Steve Turbet, 320 West Oklahoma Board of Agriculture, Division of Water Resources
 City, State, ZIP Code: Ulysses Kansas Application Number:

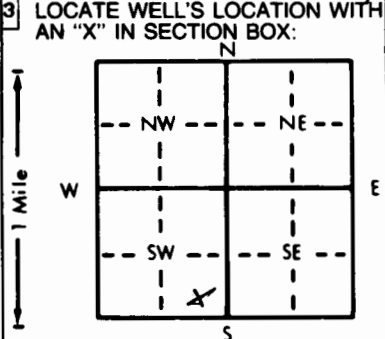

4 DEPTH OF COMPLETED WELL: 98 ft. ELEVATION: _____

Depth(s) Groundwater Encountered 1. 81.9 ft. 2. _____ ft. 3. _____ ft.

WELL'S STATIC WATER LEVEL: 81.9 ft. below land surface measured on mo/day/yr 5/28/95

Pump test data: Well water was _____ ft. after _____ hours pumping _____ gpm

Est. Yield _____ gpm: Well water was _____ ft. after _____ hours pumping _____ gpm

Bore Hole Diameter: 8.25 in. to 9.8 ft., and _____ in. to _____ ft.

WELL WATER TO BE USED AS: 5 Public water supply 8 Air conditioning 11 Injection well
 1 Domestic 3 Feedlot 6 Oil field water supply 9 Dewatering 12 Other (Specify below)
 2 Irrigation 4 Industrial 7 Lawn and garden only 10 Monitoring well

Was a chemical/bacteriological sample submitted to Department? Yes _____ No _____; If yes, mo/day/yr sample was submitted _____

Water Well Disinfected? Yes No

5 TYPE OF BLANK CASING USED: 1 Steel 3 RMP (SR) 5 Wrought iron 8 Concrete tile CASING JOINTS: Glued _____ Clamped _____
2 PVC 4 ABS 6 Asbestos-Cement 9 Other (specify below) Welded _____
 7 Fiberglass Threaded

Blank casing diameter: 2 in. to _____ ft., Dia. _____ in. to _____ ft., Dia. _____ in. to _____ ft.

Casing height above land surface: Flange Mount in., weight _____ lbs./ft. Wall thickness or gauge No. Sch 40

TYPE OF SCREEN OR PERFORATION MATERIAL: 7 PVC 10 Asbestos-cement
 1 Steel 3 Stainless steel 5 Fiberglass 8 RMP (SR) 11 Other (specify) _____
 2 Brass 4 Galvanized steel 6 Concrete tile 9 ABS 12 None used (open hole)

SCREEN OR PERFORATION OPENINGS ARE: 5 Gauzed wrapped 8 Saw cut 11 None (open hole)
 1 Continuous slot 3 Mill slot .010 6 Wire wrapped 9 Drilled holes
 2 Louvered shutter 4 Key punched 7 Torch cut 10 Other (specify) _____

SCREEN-PERFORATED INTERVALS: From 73' ft. to 98' ft., From _____ ft. to _____ ft.
 From _____ ft. to _____ ft., From _____ ft. to _____ ft.

GRAVEL PACK INTERVALS: From 71' ft. to 98' ft., From _____ ft. to _____ ft.
 From _____ ft. to _____ ft., From _____ ft. to _____ ft.

6 GROUT MATERIAL: 1 Neat cement 2 Cement grout 3 Bentonite 4 Other _____

Grout Intervals: From 2.5 ft. to 6.9 ft., From 6.9 ft. to 71 ft., From _____ ft. to _____ ft.

What is the nearest source of possible contamination: 10 Livestock pens 14 Abandoned water well
 1 Septic tank 4 Lateral lines 7 Pit privy 11 Fuel storage 15 Oil well/Gas well
 2 Sewer lines 5 Cess pool 8 Sewage lagoon 12 Fertilizer storage 16 Other (specify below)
 3 Watertight sewer lines 6 Seepage pit 9 Feedyard 13 Insecticide storage

Direction from well? _____ How many feet? _____

FROM	TO	LITHOLOGIC LOG	FROM	TO	PLUGGING INTERVALS
0	1.5	Topsoil			
1.5	70	Silty clay, light brown, damp, loose			
70	20	ALA w/ increasing silt content			
25	30	Silty minor clay L. brown & damp			
30	40	Silty sand tan w/ buff specks, sd vfn & damp			
40	45	clayey silt lt brn, damp, hard			
45	60	silt, tan, damp, fr. vfn sd			
60	70	sand, tan, damp, fn gr, subang, poorly graded, loose,			
70	80	Sand Lt. grey damp, Loose vfn gr. subrnd			
80	90	Sand, Lt brn, vfn gr, subrnd moist w/ rust streaks			
90	90.7	blue brown fine gr, rnd, poorly graded wet			
90.7	98.0	silty sand, sand, vfn, grain tan, loose			

7 CONTRACTOR'S OR LANDOWNER'S CERTIFICATION: This water well was (1) constructed (2) reconstructed, or (3) plugged under my jurisdiction and was completed on (mo/day/year) 5/28/95 and this record is true to the best of my knowledge and belief. Kansas Water Well Contractor's License No. 589 This Water Well Record was completed on (mo/day/yr) 8/16/95 under the business name of MAXIM TECHNOLOGIES by (signature) William Purdon