


1 LOCATION OF WATER WELL: Fraction NW 1/4 NE 1/4 NW 1/4 Section Number 27 Township Number T 28 S Range Number R 37 E/W
 County: Groft
 Distance and direction from nearest town or city street address of well if located within city? MW2
Main & Hwy #160, Wysses Kansas

2 WATER WELL OWNER: Bonnie Willinger Board of Agriculture, Division of Water Resources
 RR#, St. Address, Box #: Rural Route Johnson Kansas Application Number:

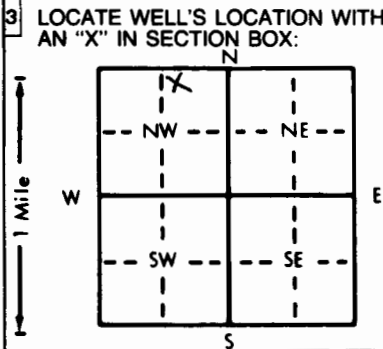

4 DEPTH OF COMPLETED WELL: 88 ft. ELEVATION:
 Depth(s) Groundwater Encountered 1. 80 ft. 2. ft. 3. ft.
 WELL'S STATIC WATER LEVEL 73.85 ft. below land surface measured on mo/day/yr 8/2/95
 Pump test data: Well water was ft. after hours pumping gpm
 Est. Yield gpm: Well water was ft. after hours pumping gpm
 Bore Hole Diameter 8.625 in. to 88 ft., and in. to ft.
 WELL WATER TO BE USED AS:
 5 Public water supply 8 Air conditioning 11 Injection well
 1 Domestic 3 Feedlot 6 Oil field water supply 9 Dewatering 12 Other (Specify below)
 2 Irrigation 4 Industrial 7 Lawn and garden only 10 Monitoring well
 Was a chemical/bacteriological sample submitted to Department? Yes No; If yes, mo/day/yr sample was submitted
 Water Well Disinfected? Yes No

5 TYPE OF BLANK CASING USED:
 1 Steel 3 RMP (SR) 5 Wrought iron 8 Concrete tile CASING JOINTS: Glued Clamped
2 PVC 4 ABS 6 Asbestos-Cement 9 Other (specify below) Welded
 7 Fiberglass Threaded
 Blank casing diameter 2 in. to 63 ft., Dia. in. to ft., Dia. in. to ft.
 Casing height above land surface Flush in., weight 0.70 lbs./ft. Wall thickness or gauge No. Sch 40
 TYPE OF SCREEN OR PERFORATION MATERIAL:
 1 Steel 3 Stainless steel 5 Fiberglass 7 PVC 10 Asbestos-cement
 2 Brass 4 Galvanized steel 6 Concrete tile 8 RMP (SR) 11 Other (specify)
 12 None used (open hole)
 SCREEN OR PERFORATION OPENINGS ARE:
 1 Continuous slot 3 Mill slot 5 Gauzed wrapped 8 Saw cut 11 None (open hole)
 2 Louvered shutter 4 Key punched 6 Wire wrapped 9 Drilled holes
 7 Torch cut 10 Other (specify)
 SCREEN-PERFORATED INTERVALS: From 63 ft. to 88 ft., From ft. to ft.
 From ft. to ft., From ft. to ft.
 GRAVEL PACK INTERVALS: From 61 ft. to 88 ft., From ft. to ft.
 From ft. to ft., From ft. to ft.

6 GROUT MATERIAL: 1 Neat cement 2 Cement grout 3 Bentonite 4 Other
 Grout Intervals: From surface to 59 ft., From 59 ft. to 61 ft., From ft. to ft.
 What is the nearest source of possible contamination:
 1 Septic tank 4 Lateral lines 7 Pit privy 10 Livestock pens 14 Abandoned water well
 2 Sewer lines 5 Cess pool 8 Sewage lagoon 11 Fuel storage 15 Oil well/Gas well
 3 Watertight sewer lines 6 Seepage pit 9 Feedyard 12 Fertilizer storage 16 Other (specify below)
 13 Insecticide storage
 Direction from well? How many feet?

FROM	TO	LITHOLOGIC LOG	FROM	TO	PLUGGING INTERVALS
0	2.7	Brown & D. Brown, silty clay, moist	50	55	<u>CON'T</u> A/A w/ fn gr sd, damp
2.7	15	Silt + clay, reddish brown, moist & loose w/ very fn sd	55	70	Silty w/ very fine grain sd, tan, loose, well graded, sub angular and damp
15	20	Silty sand, reddish brown, moist w/ minor clay	80	85	Clay light brown with minor rust streaks, sl. plasticity
20	24	Sandy silty reddish brn. moist & loose	95	88	Clay w/ silt L. brown moist med stiff and plastic
24	35	Silt, brn, loose to hard, damp w/ trace clay & v. fn sd			
35	40	Clay, L. brown, hard & stiff damp & v. low plasticity			
40	45	Silty clay, L. brn w/ caliche some dark brn. specs, damp & dry			
45	50	Silt w/ minor clay, L. brn, damp and hard			

7 CONTRACTOR'S OR LANDOWNER'S CERTIFICATION: This water well was (1) constructed (2) reconstructed, or (3) plugged under my jurisdiction and was completed on (mo/day/year) 7/20/95 and this record is true to the best of my knowledge and belief. Kansas Water Well Contractor's License No. 589 This Water Well Record was completed on (mo/day/yr) 8/16/95 under the business name of Maxim Technologies by (signature) William R. Rindor