


1] LOCATION OF WATER WELL: County: Grant Fraction: NE 1/4 NE 1/4 NW 1/4 Section Number: 34 Township Number: T 28 S Range Number: R 37 E(N)

Distance and direction from nearest town or city street address of well if located within city?
201 210 E Oklahoma Ulysses, KS 67880

2] WATER WELL OWNER: U-Serv
 RR#, St. Address, Box #: 216 E. Oklahoma Board of Agriculture, Division of Water Resources
 City, State, ZIP Code: Ulysses Kansas 67880 Application Number:

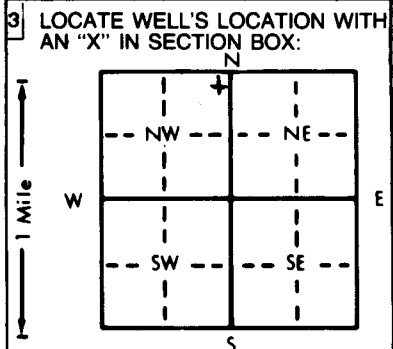

4] DEPTH OF COMPLETED WELL: 78.50 ft. ELEVATION: ft.
 Depth(s) Groundwater Encountered 1. ft. 2. ft. 3. ft.
 WELL'S STATIC WATER LEVEL 71.76 ft. below land surface measured on mo/day/yr 11/5/94
 Pump test data: Well water was ft. after hours pumping gpm
 Est. Yield gpm: Well water was ft. after hours pumping gpm
 Bore Hole Diameter: 8 in. to 79.0 ft., and in. to ft.
 WELL WATER TO BE USED AS:
 5 Public water supply 8 Air conditioning 11 Injection well
 1 Domestic 3 Feedlot 6 Oil field water supply 9 Dewatering 12 Other (Specify below)
 2 Irrigation 4 Industrial 7 Lawn and garden only 10 Monitoring well MW-5
 Was a chemical/bacteriological sample submitted to Department? Yes.....No.....; If yes, mo/day/yr sample was submitted
 Water Well Disinfected? Yes No

5] TYPE OF BLANK CASING USED:
 1 Steel 3 RMP (SR) 5 Wrought iron 8 Concrete tile CASING JOINTS: Glued Clamped
2 PVC 4 ABS 7 Fiberglass Welded
 Blank casing diameter 2 in. to 58.50 ft., Dia in. to ft., Dia in. to ft.
 Casing height above land surface: 0.0 in., weight lbs./ft. Wall thickness or gauge No. sch 40
 TYPE OF SCREEN OR PERFORATION MATERIAL: 7 PVC 10 Asbestos-cement
 1 Steel 3 Stainless steel 5 Fiberglass 8 RMP (SR) 11 Other (specify)
 2 Brass 4 Galvanized steel 6 Concrete tile 9 ABS 12 None used (open hole)
 SCREEN OR PERFORATION OPENINGS ARE:
 1 Continuous slot 3 Mill slot 5 Gauzed wrapped 8 Saw cut 11 None (open hole)
 2 Louvered shutter 4 Key punched 6 Wire wrapped 9 Drilled holes
 7 Torch cut 10 Other (specify)
 SCREEN-PERFORATED INTERVALS: From 58.50 ft. to 78.50 ft., From ft. to ft.
 GRAVEL PACK INTERVALS: From 55 ft. to 78.50 ft., From ft. to ft.

6] GROUT MATERIAL: 1 Neat cement 2 Cement grout 3 Bentonite 4 Other
 Grout Intervals: From 0 ft. to 52 ft., From 52 ft. to 55 ft., From ft. to ft.
 What is the nearest source of possible contamination:
 1 Septic tank 4 Lateral lines 7 Pit privy 10 Livestock pens 14 Abandoned water well
 2 Sewer lines 5 Cess pool 8 Sewage lagoon 11 Fuel storage 15 Oil well/Gas well
 3 Watertight sewer lines 6 Seepage pit 9 Feedyard 12 Fertilizer storage 16 Other (specify below)
UST

Direction from well? How many feet?

| FROM | TO | LITHOLOGIC LOG | FROM | TO | PLUGGING INTERVALS |
|------|------|--------------------------|------|----|--------------------|
| 0 | 0.5 | gray clayey silt | | | |
| 0.5 | 13.5 | silty clay | | | |
| 13.5 | 18.5 | silty sand | | | |
| 18.5 | 23.5 | silty sand | | | |
| 23.5 | 33.5 | silt and sand | | | |
| 33.5 | 39.8 | clayey silty sand | | | |
| 39.8 | 40 | silty clay | | | |
| 40 | 58.5 | reddish brown silty sand | | | |

7] CONTRACTOR'S OR LANDOWNER'S CERTIFICATION: This water well was (1) constructed, (2) reconstructed, or (3) plugged under my jurisdiction and was completed on (mo/day/year) 11/4/94 and this record is true to the best of my knowledge and belief. Kansas Water Well Contractor's License No. 540 This Water Well Record was completed on (mo/day/yr) 11/5/94 under the business name of Prairie Land Environmental Remediation Inc by (signature) [Signature]