


1 LOCATION OF WATER WELL: County: Grant Fraction: SE SW 1/4 S10SE 1/4 SW 1/4 Section Number: 27 Township Number: T 28 S Range Number: R 37 E/W

Distance and direction from nearest town or city street address of well if located within city? Northwest corner of Oklahoma St and Glenn in KDOT right of way

2 WATER WELL OWNER: U-Serv  
 RR#, St. Address, Box #: 216 E. Oklahoma Board of Agriculture, Division of Water Resources  
 City, State, ZIP Code: Ulysses, KS 67880 Application Number:

3 LOCATE WELL'S LOCATION WITH AN "X" IN SECTION BOX:

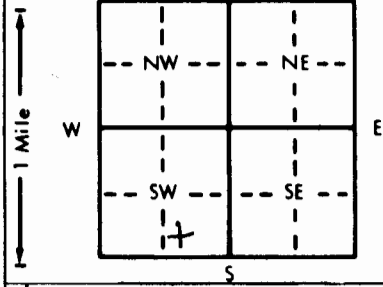

4 DEPTH OF COMPLETED WELL: 78.50 ft. ELEVATION:  
 Depth(s) Groundwater Encountered 1. 69.50 ft. 2. ft. 3. ft.  
 WELL'S STATIC WATER LEVEL: 70.99 ft. below land surface measured on mo/day/yr 11/15/96

Pump test data: Well water was ft. after hours pumping gpm  
 Est. Yield gpm: Well water was ft. after hours pumping gpm  
 Bore Hole Diameter: 8 in. to 80 ft., and in. to ft.

WELL WATER TO BE USED AS:  
 5 Public water supply 8 Air conditioning 11 Injection well  
 1 Domestic 3 Feedlot 6 Oil field water supply 9 Dewatering 12 Other (Specify below)  
 2 Irrigation 4 Industrial 7 Lawn and garden only  Monitoring well MW-4

Was a chemical/bacteriological sample submitted to Department? Yes No ; If yes, mo/day/yr sample was submitted  
 Water Well Disinfected? Yes No

5 TYPE OF BLANK CASING USED:  
 1 Steel 3 RMP (SR) 5 Wrought iron 8 Concrete tile CASING JOINTS: Glued Clamped  
 PVC 4 ABS 6 Asbestos-Cement 9 Other (specify below) Welded  
 7 Fiberglass Threaded

Blank casing diameter: 2 in. to 58.50 ft., Dia. in. to ft., Dia. in. to ft.  
 Casing height above land surface: 0.0 in., weight lbs./ft. Wall thickness or gauge No. Sch 40

TYPE OF SCREEN OR PERFORATION MATERIAL:  
 1 Steel 3 Stainless steel 5 Fiberglass 7 PVC 10 Asbestos-cement  
 2 Brass 4 Galvanized steel 6 Concrete tile 8 RMP (SR) 11 Other (specify)  
 12 None used (open hole)

SCREEN OR PERFORATION OPENINGS ARE:  
 1 Continuous slot  Mill slot 5 Gauzed wrapped 8 Saw cut 11 None (open hole)  
 2 Louvered shutter 4 Key punched 6 Wire wrapped 9 Drilled holes  
 7 Torch cut 10 Other (specify)

SCREEN-PERFORATED INTERVALS: From 58.50 ft. to 78.50 ft., From ft. to ft.  
 From ft. to ft., From ft. to ft.  
 GRAVEL PACK INTERVALS: From 5.7 ft. to 78.50 ft., From ft. to ft.  
 From ft. to ft., From ft. to ft.

6 GROUT MATERIAL: 1 Neat cement  Cement grout 54  Bentonite 54  Other 57  
 Grout Intervals: From 0 ft. to 5.4 ft., From 5.4 ft. to 57 ft., From ft. to ft.

What is the nearest source of possible contamination:  
 1 Septic tank 4 Lateral lines 7 Pit privy 10 Livestock pens 14 Abandoned water well  
 2 Sewer lines 5 Cess pool 8 Sewage lagoon 11 Fuel storage 15 Oil well/Gas well  
 3 Watertight sewer lines 6 Seepage pit 9 Feedyard 12 Fertilizer storage  Other (specify below) UST  
 13 Insecticide storage

Direction from well? EAST How many feet? 150

FROM	TO	LITHOLOGIC LOG	FROM	TO	PLUGGING INTERVALS
0	13.5	clayey silt			
13.5	23.5	silty sand			
23.5	38.5	silty clay			
38.5	39.8	silty sand			
39.8	48.5	silty clay			
48.5	70	sand			

7 CONTRACTOR'S OR LANDOWNER'S CERTIFICATION: This water well was  constructed,  reconstructed, or  plugged under my jurisdiction and was completed on (mo/day/year) 12/30/95 and this record is true to the best of my knowledge and belief. Kansas Water Well Contractor's License No. 540 This Water Well Record was completed on (mo/day/yr) 11/15/96 under the business name of Prairie Land Environmental Remediation Inc by (signature)