


1 LOCATION OF WATER WELL: County: Grant Fraction SW 1/4 SE 1/4 SW 1/4 Section Number 27 Township Number T 28 S Range Number R 37 E(W)

Distance and direction from nearest town or city street address of well if located within city?
216 E Oklzhoma Ulysses, KS 67880

2 WATER WELL OWNER: U-Serv
 RR#, St. Address, Box #: 216 E. Oklzhoma Board of Agriculture, Division of Water Resources
 City, State, ZIP Code: Ulysses, KS 67880 Application Number:

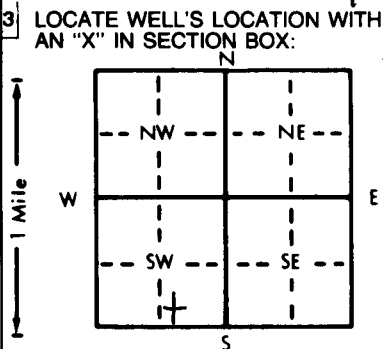

4 DEPTH OF COMPLETED WELL... 80 ft. ELEVATION: ft.
 Depth(s) Groundwater Encountered 1. 69.8 ft. 2. ft. 3. ft.
 WELL'S STATIC WATER LEVEL 71.83 ft. below land surface measured on mo/day/yr 11/15/96
 Pump test data: Well water was ft. after hours pumping gpm
 Est. Yield gpm: Well water was ft. after hours pumping gpm
 Bore Hole Diameter... 8 in. to 80 ft., and in. to ft.
 WELL WATER TO BE USED AS: 5 Public water supply 8 Air conditioning 11 Injection well
 1 Domestic 3 Feedlot 6 Oil field water supply 9 Dewatering 12 Other (Specify below)
 2 Irrigation 4 Industrial 7 Lawn and garden only 10 Monitoring well mw-7
 Was a chemical/bacteriological sample submitted to Department? Yes.....No.....; If yes, mo/day/yr sample was submitted
 Water Well Disinfected? Yes No

5 TYPE OF BLANK CASING USED: 5 Wrought iron 8 Concrete tile CASING JOINTS: Glued Clamped
 1 Steel 3 RMP (SR) 6 Asbestos-Cement 9 Other (specify below) Welded
2 PVC 4 ABS 7 Fiberglass Threaded.
 Blank casing diameter 2 in. to 60 ft., Dia. in. to ft., Dia. in. to ft.
 Casing height above land surface 1.0 in., weight lbs./ft. Wall thickness or gauge No. sbh 40
 TYPE OF SCREEN OR PERFORATION MATERIAL: 7 PVC 10 Asbestos-cement
 1 Steel 3 Stainless steel 5 Fiberglass 8 RMP (SR) 11 Other (specify)
 2 Brass 4 Galvanized steel 6 Concrete tile 9 ABS 12 None used (open hole)
 SCREEN OR PERFORATION OPENINGS ARE: 5 Gauzed wrapped 8 Saw cut 11 None (open hole)
 1 Continuous slot 3 Mill slot 6 Wire wrapped 9 Drilled holes
 2 Louvered shutter 4 Key punched 7 Torch cut 10 Other (specify)
 SCREEN-PERFORATED INTERVALS: From ft. to 80 ft., From ft. to ft.
 From ft. to ft., From ft. to ft.
 GRAVEL PACK INTERVALS: From 5.7 ft. to 80 ft., From ft. to ft.
 From ft. to ft., From ft. to ft.

6 GROUT MATERIAL: 1 Neat cement 2 Cement grout 3 Bentonite 4 Other
 Grout Intervals: From 0 ft. to 54 ft., From 54 ft. to 57 ft., From ft. to ft.
 What is the nearest source of possible contamination:
 1 Septic tank 4 Lateral lines 7 Pit privy 10 Livestock pens 14 Abandoned water well
 2 Sewer lines 5 Cess pool 8 Sewage lagoon 11 Fuel storage 15 Oil well/Gas well
 3 Watertight sewer lines 6 Seepage pit 9 Feedyard 12 Fertilizer storage 16 Other (specify below) UST
 13 Insecticide storage
 Direction from well? South west How many feet? 85 ft

FROM	TO	LITHOLOGIC LOG	FROM	TO	PLUGGING INTERVALS
0	29.7	Tan silty sand			
29.7	33.5	Tan sandy clay			
33.5	39.8	Brown silty sand			
39.8	43.5	silty clay			
43.5	80	silty sand			

7 CONTRACTOR'S OR LANDOWNER'S CERTIFICATION: This water well was (1) constructed, (2) reconstructed, or (3) plugged under my jurisdiction and was completed on (mo/day/year) 11/9/96 and this record is true to the best of my knowledge and belief. Kansas Water Well Contractor's License No. 540 This Water Well Record was completed on (mo/day/yr) 11/15/96 under the business name of Prairie Land Environmental Remediation Inc by (signature)