


1 LOCATION OF WATER WELL: County: Grant Fraction: SE 1/4 NE 1/4 SW 1/4 Section Number: 17 Township Number: T 28 S Range Number: R 37 EW

Distance and direction from nearest town or city street address of well if located within city?  
1/2 W - 1 N of Ulysses, KS

2 WATER WELL OWNER: Brat Wilkie  
RR#, St. Address, Box #: Ulysses, KS 67880  
City, State, ZIP Code: \_\_\_\_\_  
Board of Agriculture, Division of Water Resources  
Application Number: \_\_\_\_\_

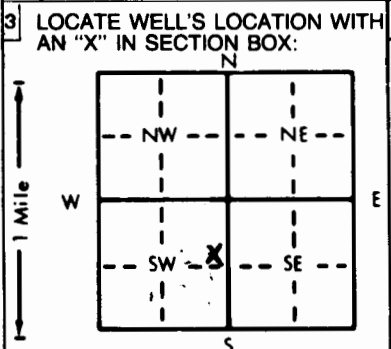

4 DEPTH OF COMPLETED WELL: 410 ft. ELEVATION: Slope  
Depth(s) Groundwater Encountered 1. 240 ft. 2. \_\_\_\_\_ ft. 3. \_\_\_\_\_ ft.  
WELL'S STATIC WATER LEVEL: 240 ft. below land surface measured on mo/day/yr 5-17-96  
Pump test data: Well water was 245 ft. after 3 hours pumping 10 gpm  
Est. Yield 55 gpm: Well water was \_\_\_\_\_ ft. after \_\_\_\_\_ hours pumping \_\_\_\_\_ gpm  
Bore Hole Diameter: 9 7/8 in. to 410 ft., and \_\_\_\_\_ in. to \_\_\_\_\_ ft.  
WELL WATER TO BE USED AS:  
 Domestic 3 Feedlot 6 Oil field water supply 9 Dewatering 12 Other (Specify below)  
2 Irrigation 4 Industrial 7 Lawn and garden only 10 Monitoring well  
Was a chemical/bacteriological sample submitted to Department? Yes \_\_\_\_\_ No ; If yes, mo/day/yr sample was submitted \_\_\_\_\_  
Water Well Disinfected? Yes  No \_\_\_\_\_

5 TYPE OF BLANK CASING USED:  
1 Steel 3 RMP (SR) 6 Asbestos-Cement 9 Other (specify below) Welded \_\_\_\_\_  
 PVC 4 ABS 7 Fiberglass \_\_\_\_\_ Threaded \_\_\_\_\_  
Blank casing diameter: 5 in. to 370 ft. Dia. \_\_\_\_\_ in. to \_\_\_\_\_ ft. Dia. \_\_\_\_\_ in. to \_\_\_\_\_ ft.  
Casing height above land surface: 18 in., weight: Schedule 80 PVC lbs./ft. Wall thickness or gauge No. \_\_\_\_\_  
TYPE OF SCREEN OR PERFORATION MATERIAL:  
1 Steel 3 Stainless steel 5 Fiberglass 8 RMP (SR) 10 Asbestos-cement  
2 Brass 4 Galvanized steel 6 Concrete tile 9 ABS 11 Other (specify) \_\_\_\_\_  
12 None used (open hole)  
SCREEN OR PERFORATION OPENINGS ARE:  
1 Continuous slot 3 Mill slot 5 Gauzed wrapped 8 Saw cut 11 None (open hole)  
2 Louvered shutter 4 Key punched 6 Wire wrapped 9 Drilled holes  
7 Torch cut 10 Other (specify) \_\_\_\_\_  
SCREEN-PERFORATED INTERVALS: From 370 ft. to 410 ft., From \_\_\_\_\_ ft. to \_\_\_\_\_ ft.  
From \_\_\_\_\_ ft. to \_\_\_\_\_ ft., From \_\_\_\_\_ ft. to \_\_\_\_\_ ft.  
GRAVEL PACK INTERVALS: From 24 ft. to 410 ft., From \_\_\_\_\_ ft. to \_\_\_\_\_ ft.  
From \_\_\_\_\_ ft. to \_\_\_\_\_ ft., From \_\_\_\_\_ ft. to \_\_\_\_\_ ft.

6 GROUT MATERIAL: 1 Neat cement 2 Cement grout 3 Bentonite 4 Other \_\_\_\_\_  
Grout Intervals: From 4 ft. to 24 ft., From \_\_\_\_\_ ft. to \_\_\_\_\_ ft., From \_\_\_\_\_ ft. to \_\_\_\_\_ ft.  
What is the nearest source of possible contamination:  
1 Septic tank 4 Lateral lines 7 Pit privy 10 Livestock pens 14 Abandoned water well  
2 Sewer lines 5 Cess pool 8 Sewage lagoon 11 Fuel storage 15 Oil well/Gas well  
3 Watertight sewer lines 6 Seepage pit 9 Feedyard 12 Fertilizer storage 16 Other (specify below)  
13 Insecticide storage \_\_\_\_\_  
Direction from well? \_\_\_\_\_ How many feet? None

FROM	TO	LITHOLOGIC LOG	FROM	TO	PLUGGING INTERVALS
0	2	Surface			
2	40	Brown clay			
40	65	Fine sand			
65	80	Coarse sand			
80	240	Brown & gray clay			
240	282	Medium to coarse sand w/ clay breakers			
282	375	Clay w/ small sand strips			
375	410	Fine to coarse sand			
410	420	Brown & blue clay			

7 CONTRACTOR'S OR LANDOWNER'S CERTIFICATION: This water well was  (1) constructed,  (2) reconstructed, or  (3) plugged under my jurisdiction and was completed on (mo/day/year) 5-16-96 and this record is true to the best of my knowledge and belief. Kansas Water Well Contractor's License No. 164 This Water Well Record was completed on (mo/day/yr) 6-24-96 under the business name of Horick Bros. Only Co. by (signature) M. Beard