


mw-3

1 LOCATION OF WATER WELL: Fraction **NW NE NW** Section Number **34** Township Number **28 S** Range Number **37 E**
 County: **Grant**
 Distance and direction from nearest town or city street address of well if located within city?
103 E. Oklahoma, Olysses, Kansas

2 WATER WELL OWNER: **Taylor Food Mart #629 C/O Brian Cobb**
 RR#, St. Address, Box # **2550 N. Loop West #60, Houston, TX 77092**
 City, State, ZIP Code
 Board of Agriculture, Division of Water Resources
 Application Number: _____

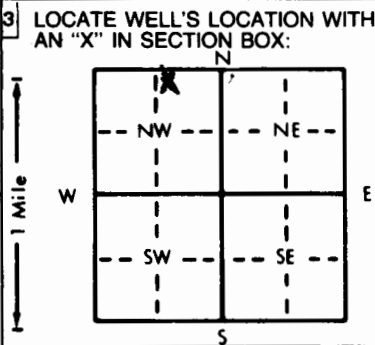

4 DEPTH OF COMPLETED WELL: **85** ft. ELEVATION: _____
 Depth(s) Groundwater Encountered 1. **73** ft. 2. _____ ft. 3. _____ ft.
 WELL'S STATIC WATER LEVEL **71.95** ft. below land surface measured on mo/day/yr **4-3-97**
 Pump test data: Well water was _____ ft. after _____ hours pumping _____ gpm
 Est. Yield _____ gpm: Well water was _____ ft. after _____ hours pumping _____ gpm
 Bore Hole Diameter **8.625** in. to **8.5** in. and _____ in. to _____ in. ft.
 WELL WATER TO BE USED AS: 5 Public water supply 8 Air conditioning 11 Injection well
 1 Domestic 3 Feedlot 6 Oil field water supply 9 Dewatering 12 Other (Specify below)
 2 Irrigation 4 Industrial 7 Lawn and garden only **10 Monitoring well mw-3**
 Was a chemical/bacteriological sample submitted to Department? Yes _____ No **X**; If yes, mo/day/yr sample was submitted _____
 Water Well Disinfected? Yes _____ No **X**

5 TYPE OF CASING USED:
 1 Steel 3 RMP (SR) 5 Wrought iron 8 Concrete tile CASING JOINTS: Glued _____ Clamped _____
 2 PVC 4 ABS 6 Asbestos-Cement 9 Other (specify below) Welded _____
 7 Fiberglass _____ Threaded **X**
 Blank casing diameter **2** in. to **6.5** ft. Dia. _____ in. to _____ ft. Dia. _____ in. to _____ ft.
 Casing height above land surface **0** in., weight **SCH 40 PVC** lbs./ft. Wall thickness or gauge No. _____
 TYPE OF SCREEN OR PERFORATION MATERIAL:
 1 Steel 3 Stainless steel 5 Fiberglass 8 RMP (SR) 10 Asbestos-cement
 2 Brass 4 Galvanized steel 6 Concrete tile 9 ABS 11 Other (specify) _____
 12 None used (open hole)
 SCREEN OR PERFORATION OPENINGS ARE:
 1 Continuous slot 3 Mill slot 5 Gauzed wrapped 8 Saw cut 11 None (open hole)
 2 Louvered shutter 4 Key punched 6 Wire wrapped 9 Drilled holes
 7 Torch cut 10 Other (specify) _____
 SCREEN-PERFORATED INTERVALS: From **6.5** ft. to **8.5** ft. From _____ ft. to _____ ft.
 From _____ ft. to _____ ft. From _____ ft. to _____ ft.
SAND
 GRAVEL PACK INTERVALS: From **6.4** ft. to **8.5** ft. From _____ ft. to _____ ft.
 From _____ ft. to _____ ft. From _____ ft. to _____ ft.

6 GROUT MATERIAL: 1 Neat cement 2 Cement grout 3 Bentonite 4 Other _____
 Grout Intervals: From **0** ft. to **6.2** ft., From **3.62** ft. to **6.4** ft., From _____ ft. to _____ ft.
 What is the nearest source of possible contamination:
 1 Septic tank 4 Lateral lines 7 Pit privy 10 Livestock pens 14 Abandoned water well
 2 Sewer lines 5 Cess pool 8 Sewage lagoon 11 Fuel storage 15 Oil well/Gas well
 3 Watertight sewer lines 6 Seepage pit 9 Feedyard 12 Fertilizer storage **16 Other (specify below)**
Contaminated Si
 Direction from well? _____ How many feet? _____

FROM	TO	LITHOLOGIC LOG	FROM	TO	PLUGGING INTERVALS
GL	0.50	Gravel, fill sand			
0.50	10.00	Silt (ML)			
10.00	23.00	Silt w/clay			
23.00	27.00	Silt w/sand			
27.00	56.00	Silt w/clay			
56.00	67.00	Silt w/sand			
67.00	84.00	Sand			
84.00	TD	End of Borehole			
					Flush Mount waiver
					D. Taylor

7 CONTRACTOR'S OR LANDOWNER'S CERTIFICATION: This water well was **(1) constructed, (2) reconstructed, or (3) plugged** under my jurisdiction and was completed on (mo/day/year) **4-3-97** and this record is true to the best of my knowledge and belief. Kansas Water Well Contractor's License No. **585** This Water Well Record was completed on (mo/day/yr) **4-8-97** under the business name of **AEI** by (signature) *D. Taylor*

OFFICE USE ONLY