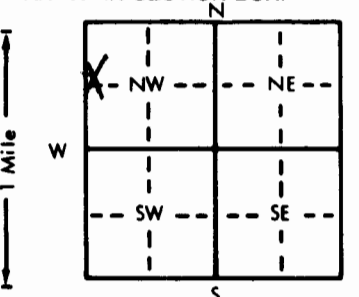


1 LOCATION OF WATER WELL: County: Grant #7 Fraction: SW 1/4 NW 1/4 NW 1/4 Section Number: 4 Township Number: T 35 28 S Range Number: R 33 37 EW

Distance and direction from nearest town or city street address of well if located within city?
409 West Miller Avenue Ulysses, Kansas

2 WATER WELL OWNER: City Of Ulysses
 RR#, St. Address, Box #: 115 West Grant Board of Agriculture, Division of Water Resources
 City, State, ZIP Code: Ulysses Kansas 67880 Application Number:

3 LOCATE WELL'S LOCATION WITH AN "X" IN SECTION BOX:

 4 DEPTH OF COMPLETED WELL: 80 ft. ELEVATION:
 Depth(s) Groundwater Encountered: 1. 7.5 ft. 2. ft. 3. ft.
 WELL'S STATIC WATER LEVEL: 7.5 ft. below land surface measured on mo/day/yr 5/26/92
 Pump test data: Well water was ft. after hours pumping gpm
 Est. Yield gpm: Well water was ft. after hours pumping gpm
 Bore Hole Diameter: 8 in. to 80 ft., and in. to ft.
 WELL WATER TO BE USED AS:
 5 Public water supply 8 Air conditioning 11 Injection well
 1 Domestic 3 Feedlot 6 Oil field water supply 9 Dewatering 12 Other (Specify below)
 2 Irrigation 4 Industrial 7 Lawn and garden only 10 Monitoring well
 Was a chemical/bacteriological sample submitted to Department? Yes.....No...X..... If yes, mo/day/yr sample was submitted
 Water Well Disinfected? Yes No X

5 TYPE OF BLANK CASING USED:
 1 Steel 3 RMP (SR) 5 Wrought iron 8 Concrete tile CASING JOINTS: Glued...X...Clamped...
2 PVC 4 ABS 6 Asbestos-Cement 9 Other (specify below) Welded...
 7 Fiberglass Threaded...
 Blank casing diameter: 4 in. to 60 ft., Dia. in. to ft., Dia. in. to ft.
 Casing height above land surface: 0 in., weight lbs./ft. Wall thickness or gauge No. Schedule 40
 TYPE OF SCREEN OR PERFORATION MATERIAL:
 1 Steel 3 Stainless steel 5 Fiberglass 7 PVC 10 Asbestos-cement
 2 Brass 4 Galvanized steel 6 Concrete tile 9 ABS 11 Other (specify) ...
 12 None used (open hole)
 SCREEN OR PERFORATION OPENINGS ARE:
 1 Continuous slot 3 Mill slot 5 Gauzed wrapped 8 Saw cut 11 None (open hole)
 2 Louvered shutter 4 Key punched 6 Wire wrapped 9 Drilled holes
 7 Torch cut 10 Other (specify) ...
 SCREEN-PERFORATED INTERVALS: From 60 ft. to 80 ft., From ft. to ft.
 From ft. to ft., From ft. to ft.
 GRAVEL PACK INTERVALS: From 15 ft. to 80 ft., From ft. to ft.
 From ft. to ft., From ft. to ft.

6 GROUT MATERIAL: 1 Neat cement 2 Cement grout 3 Bentonite 4 Other
 Grout intervals: From 1 ft. to 15 ft., From ft. to ft., From ft. to ft.
 What is the nearest source of possible contamination:
 1 Septic tank 4 Lateral lines 7 Pit privy 10 Livestock pens 14 Abandoned water well
 2 Sewer lines 5 Cess pool 8 Sewage lagoon 11 Fuel storage 15 Oil well/Gas well
 3 Watertight sewer lines 6 Seepage pit 9 Feedyard 12 Fertilizer storage 16 Other (specify below)
 13 Insecticide storage
 Direction from well? South How many feet? 100'

FROM	TO	LITHOLOGIC LOG	FROM	TO	PLUGGING INTERVALS
1	16	Top Soil			
		Clay			
16	30	Red Sands			
30	37	Clay, Sands			
37	40	Clays (Hard)			
45	45	White Sands			
45	55	Fine Sands, Clay Mix			
55	75	White Sand			
75	80	Water, Sands, Some Clay			

7 CONTRACTOR'S OR LANDOWNER'S CERTIFICATION: This water well was (1) constructed, (2) reconstructed, or (3) plugged under my jurisdiction and was completed on (mo/day/year) 5/29/92 CO-107-535 and this record is true to the best of my knowledge and belief. Kansas Water Well Contractor's License No. 67192 This Water Well Record was completed on (mo/day/yr) 5/27/92 by (signature) James O. Puyear under the business name of Puyear Contractors Inc.