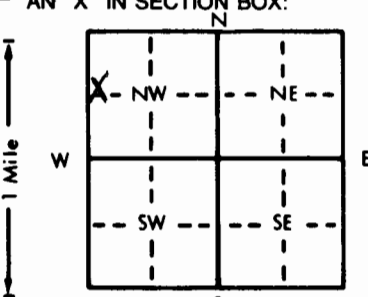


1 LOCATION OF WATER WELL: County: Grant # 5 Fraction: SW 1/4 NW 1/4 NW 1/4 Section Number: 4 Township Number: T 28 S Range Number: R 37 EW

Distance and direction from nearest town or city street address of well if located within city?

409 West Miller Avenue Ulysses, Kansas

2 WATER WELL OWNER: City Of Ulysses RR#, St. Address, Box #: 115 West Grant Board of Agriculture, Division of Water Resources City, State, ZIP Code: Ulysses Kansas 67880 Application Number:

3 LOCATE WELL'S LOCATION WITH AN "X" IN SECTION BOX:  4 DEPTH OF COMPLETED WELL: 80 ft. ELEVATION: Depth(s) Groundwater Encountered: 1. 7.5 ft. 2. ft. 3. ft. WELL'S STATIC WATER LEVEL: 7.5 ft. below land surface measured on mo/day/yr 5/26/92 Pump test data: Well water was ft. after hours pumping gpm Est. Yield gpm: Well water was ft. after hours pumping gpm Bore Hole Diameter: 8 in. to 80 ft., and in. to ft. WELL WATER TO BE USED AS: 5 Public water supply 8 Air conditioning 11 Injection well 1 Domestic 3 Feedlot 6 Oil field water supply 9 Dewatering 12 Other (Specify below) 2 Irrigation 4 Industrial 7 Lawn and garden only 10 Monitoring well Was a chemical/bacteriological sample submitted to Department? Yes.....No...X.....; If yes, mo/day/yr sample was submitted Water Well Disinfected? Yes No X

5 TYPE OF BLANK CASING USED: 1 Steel 2 PVC 3 RMP (SR) 4 ABS 5 Wrought iron 6 Asbestos-Cement 7 Fiberglass 8 Concrete tile 9 Other (specify below) CASING JOINTS: Glued X Clamped Welded Threaded. Blank casing diameter: 4 in. to 60 ft., Dia. in. to ft., Dia. in. to ft. Casing height above land surface: 0 in., weight lbs./ft. Wall thickness or gauge No. Schedule 40. TYPE OF SCREEN OR PERFORATION MATERIAL: 1 Steel 2 Brass 3 Stainless steel 4 Galvanized steel 5 Fiberglass 6 Concrete tile 7 PVC 8 RMP (SR) 9 ABS 10 Asbestos-cement 11 Other (specify) 12 None used (open hole) SCREEN OR PERFORATION OPENINGS ARE: 1 Continuous slot 2 Louvered shutter 3 Mill slot 4 Key punched 5 Gauzed wrapped 6 Wire wrapped 7 Torch cut 8 Saw cut 9 Drilled holes 10 Other (specify) 11 None (open hole) SCREEN-PERFORATED INTERVALS: From 60 ft. to 80 ft., From ft. to ft. GRAVEL PACK INTERVALS: From 15 ft. to 80 ft., From ft. to ft.

6 GROUT MATERIAL: 1 Neat cement 2 Cement grout 3 Bentonite 4 Other Grout Intervals: From 1 ft. to 15 ft., From ft. to ft., From ft. to ft. What is the nearest source of possible contamination: 1 Septic tank 2 Sewer lines 3 Watertight sewer lines 4 Lateral lines 5 Cess pool 6 Seepage pit 7 Pit privy 8 Sewage lagoon 9 Feedyard 10 Livestock pens 11 Fuel storage 12 Fertilizer storage 13 Insecticide storage 14 Abandoned water well 15 Oil well/Gas well 16 Other (specify below)

Direction from well?

FROM	TO	LITHOLOGIC LOG	FROM	TO	PLUGGING INTERVALS
		Top Soil			
5	20	Clay			
20	30	Red Sands			
30	35	Clay, Sands			
35	50	Clays (Hard)			
50	57	White Sands			
57	72	Fine Sands, Clay Mix			
72	75	White Sand			
75	80	Water, Sands, Some Clay			

7 CONTRACTOR'S OR LANDOWNER'S CERTIFICATION: This water well was (1) constructed, (2) reconstructed, or (3) plugged under my jurisdiction and was completed on (mo/day/year) 7/29/92 CO 107 535 and this record is true to the best of my knowledge and belief. Kansas Water Well Contractor's License No. 107 535 This Water Well Record was completed on (mo/day/yr) 8/1/92 by (signature) James O. Puyear under the business name of Puyear Contractors Inc.