


1 LOCATION OF WATER WELL: County: Grant # 2 Fraction: SW 1/4 NW 1/4 NW 1/4 Section Number: 4 Township Number: T 38 S Range Number: R 37 EW

Distance and direction from nearest town or city street address of well if located within city?

409 West Miller Avenue Ulysses, Kansas

2 WATER WELL OWNER: City Of Ulysses
 RR#, St. Address, Box #: 115 West Grant Board of Agriculture, Division of Water Resources
 City, State, ZIP Code: Ulysses Kansas 67880 Application Number:

3 LOCATE WELL'S LOCATION WITH AN "X" IN SECTION BOX:

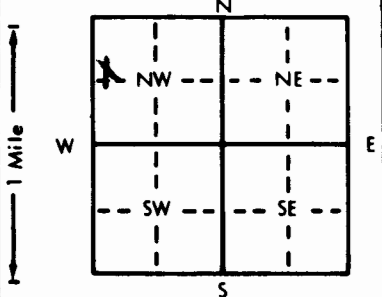

4 DEPTH OF COMPLETED WELL: 80 ft. ELEVATION: _____
 Depth(s) Groundwater Encountered: 1. 75 ft. 2. _____ ft. 3. _____ ft.
 WELL'S STATIC WATER LEVEL: 75 ft. below land surface measured on mo/day/yr: 5/26/92
 Pump test data: Well water was _____ ft. after _____ hours pumping _____ gpm
 Est. Yield _____ gpm: Well water was _____ ft. after _____ hours pumping _____ gpm
 Bore Hole Diameter: 8 in. to 80 in. to _____ ft. and _____ in. to _____ ft.
 WELL WATER TO BE USED AS:
 5 Public water supply 8 Air conditioning 11 Injection well
 1 Domestic 3 Feedlot 6 Oil field water supply 9 Dewatering 12 Other (Specify below)
 2 Irrigation 4 Industrial 7 Lawn and garden only 10 Monitoring well
 Was a chemical/bacteriological sample submitted to Department? Yes _____ No X; If yes, mo/day/yr sample was submitted _____
 Water Well Disinfected? Yes _____ No X

5 TYPE OF BLANK CASING USED:
 1 Steel 3 RMP (SR) 5 Wrought iron 8 Concrete tile CASING JOINTS: Glued X Clamped _____
2 PVC 4 ABS 6 Asbestos-Cement 9 Other (specify below) Welded _____
 7 Fiberglass Threaded _____
 Blank casing diameter: 4 in. to 60 ft., Dia _____ in. to _____ ft., Dia _____ in. to _____ ft.
 Casing height above land surface: 0 in., weight _____ lbs./ft. Wall thickness or gauge No. Schedule 40
 TYPE OF SCREEN OR PERFORATION MATERIAL:
 1 Steel 3 Stainless steel 5 Fiberglass 7 PVC 10 Asbestos-cement
 2 Brass 4 Galvanized steel 6 Concrete tile 9 ABS 11 Other (specify) _____
 12 None used (open hole)
 SCREEN OR PERFORATION OPENINGS ARE:
 1 Continuous slot 3 Mill slot 5 Gauzed wrapped 8 Saw cut 11 None (open hole)
 2 Louvered shutter 4 Key punched 6 Wire wrapped 9 Drilled holes
 7 Torch cut 10 Other (specify) _____
 SCREEN-PERFORATED INTERVALS: From 30 ft. to 40 ft., From _____ ft. to _____ ft.
 From 70 ft. to 80 ft., From _____ ft. to _____ ft.
 GRAVEL PACK INTERVALS: From 15 ft. to 48 ft., From _____ ft. to _____ ft.
 From 58 ft. to 80 ft., From _____ ft. to _____ ft.

6 GROUT MATERIAL: 1 Neat cement 2 Cement grout 3 Bentonite 4 Other _____
 Grout Intervals: From 1 ft. to 15 ft., From 48 ft. to 58 ft., From _____ ft. to _____ ft.
 What is the nearest source of possible contamination:
 1 Septic tank 4 Lateral lines 7 Pit privy 11 Fuel storage 14 Abandoned water well
 2 Sewer lines 5 Cess pool 8 Sewage lagoon 12 Fertilizer storage 15 Oil well/Gas well
 3 Watertight sewer lines 6 Seepage pit 9 Feedyard 13 Insecticide storage 16 Other (specify below)
 Direction from well? _____ How many feet? 25'

FROM	TO	LITHOLOGIC LOG	FROM	TO	PLUGGING INTERVALS
5	20	Top Soil			
		Clay			
20	30	Red Sands			
30	35	Clay, Sands			
35	50	Clays (Hard)			
50	57	White Sands			
57	72	Fine Sands, Clay Mix			
72	75	White Sand			
75	80	Water, Sands, Some Clay			

7 CONTRACTOR'S OR LANDOWNER'S CERTIFICATION: This water well was (1) constructed, (2) reconstructed, or (3) plugged under my jurisdiction and was completed on (mo/day/year) 7/25/92 and this record is true to the best of my knowledge and belief. Kansas Water Well Contractor's License No. CO-107-535 This Water Well Record was completed on (mo/day/yr) 6/1/92 by (signature) James O. Puyear under the business name of Puyear Contractors Inc.