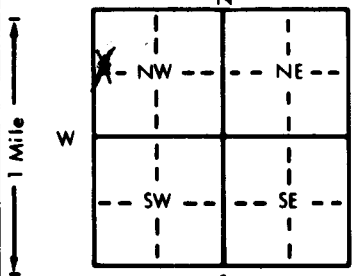


1 LOCATION OF WATER WELL: County: Grant # 13 Fraction: SW 1/4 NW 1/4 NW 1/4 Section Number: 4 Township Number: T 28 S Range Number: R 37 EW

Distance and direction from nearest town or city street address of well if located within city?
409 W Miller Avn. Ulysses Kansas

2 WATER WELL OWNER: City of Ulysses
 RR#, St. Address, Box #: 115 W Grant
 City, State, ZIP Code: Ulysses Kansas 67880
 Board of Agriculture, Division of Water Resources
 Application Number:

3 LOCATE WELL'S LOCATION WITH AN "X" IN SECTION BOX:

 4 DEPTH OF COMPLETED WELL: 80 ft. ELEVATION:
 Depth(s) Groundwater Encountered: 1 75 ft. 2. ft. 3. ft.
 WELL'S STATIC WATER LEVEL: 75 ft. below land surface measured on 5/26/92
 Pump test data: Well water was ft. after hours pumping gpm
 Est. Yield gpm: Well water was ft. after hours pumping gpm
 Bore Hole Diameter: 8 in. to 80 ft., and in. to ft.
 WELL WATER TO BE USED AS:
 1 Domestic 3 Feedlot 6 Oil field water supply 9 Dewatering 12 Other (Specify below)
 2 Irrigation 4 Industrial 7 Lawn and garden only 10 Monitoring well
 Was a chemical/bacteriological sample submitted to Department? Yes.....No. X.....; If yes, mo/day/yr sample was submitted
 Water Well Disinfected? Yes No X

5 TYPE OF BLANK CASING USED:
 1 Steel 2 PVC 3 RMP (SR) 4 ABS 5 Wrought iron 6 Asbestos-Cement 7 Fiberglass 8 Concrete tile 9 Other (specify below) CASING JOINTS: Glued Clamped Welded Threaded
 Blank casing diameter: 4 in. to 80 ft., Dia. in. to ft., Dia. in. to ft.
 Casing height above land surface: 0 in., weight lbs./ft. Wall thickness or gauge No. sch 40
 TYPE OF SCREEN OR PERFORATION MATERIAL:
 1 Steel 2 Brass 3 Stainless steel 4 Galvanized steel 5 Fiberglass 6 Concrete tile 7 PVC 8 RMP (SR) 9 ABS 10 Asbestos-cement 11 Other (specify) 12 None used (open hole)
 SCREEN OR PERFORATION OPENINGS ARE:
 1 Continuous slot 2 Louvered shutter 3 Mill slot 4 Key punched 5 Gauzed wrapped 6 Wire wrapped 7 Torch cut 8 Saw cut 9 Drilled holes 11 None (open hole) 12 Other (specify)
 SCREEN-PERFORATED INTERVALS: From 60 ft. to 80 ft., From ft. to ft.
 GRAVEL PACK INTERVALS: From 15 ft. to 80 ft., From ft. to ft.

6 GROUT MATERIAL: 1 Neat cement 2 Cement grout 3 Bentonite 4 Other
 Grout intervals: From 1 ft. to 15 ft., From ft. to ft., From ft. to ft.
 What is the nearest source of possible contamination:
 1 Septic tank 2 Sewer lines 3 Watertight sewer lines 4 Lateral lines 5 Cess pool 6 Seepage pit 7 Pit privy 8 Sewage lagoon 9 Feedyard 10 Livestock pens 11 Fuel storage 12 Fertilizer storage 13 Insecticide storage 14 Abandoned water well 15 Oil well/Gas well 16 Other (specify below)

Direction from well? SE How many feet? 75

FROM	TO	LITHOLOGIC LOG	FROM	TO	PLUGGING INTERVALS
0	5	Top soil	0	15	bentonite
5	15	fill dirt			
15	27	Red sand			
27	35	clay, sand, dix			
35	47	clays			
47	54	white sands			
54	60	hard fine clays, sands			
60	73	white sand			
Water	80	water, sands			

7 CONTRACTOR'S OR LANDOWNER'S CERTIFICATION: This water well was (1) constructed, (2) reconstructed, or (3) plugged under my jurisdiction and was completed on (mo/day/year) 4/26/92 and this record is true to the best of my knowledge and belief. Kansas Water Well Contractor's License No. CO 107 535 This Water Well Record was completed on (mo/day/yr) 5/26/92 under the business name of Puyear Contractors Inc. by (signature) James O. Puyear

INSTRUCTIONS: Use typewriter or ball point pen. PLEASE PRESS FIRMLY and PRINT clearly. Please fill in blanks, underline or circle the correct answers. Send top three copies to Kansas Department of Health and Environment, Bureau of Water, Topeka, Kansas 66620-0001. Telephone: 913-296-5545. Send one to WATER WELL OWNER and retain one for your records.