


1 LOCATION OF WATER WELL: County: Grant #14 Fraction SW 1/4 NW 1/4 NW 1/4 Section Number 4 Township Number T 28 S Range Number R 37 EW

Distance and direction from nearest town or city street address of well if located within city?
409 West Miller Avenue Ulysses, Kansas

2 WATER WELL OWNER: City Of Ulysses
RR#, St. Address, Box # : 115 West Grant Board of Agriculture, Division of Water Resources
City, State, ZIP Code : Ulysses Kansas 67880 Application Number:

3 LOCATE WELL'S LOCATION WITH AN "X" IN SECTION BOX:

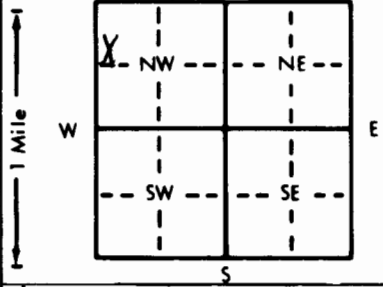

4 DEPTH OF COMPLETED WELL... 8.0 ft. ELEVATION:
Depth(s) Groundwater Encountered 1... 7.5 ft. 2... ft. 3... ft.
WELL'S STATIC WATER LEVEL .75 ft. below land surface measured on mo/day/yr 5/26/92
Pump test data: Well water was ft. after hours pumping gpm
Est. Yield gpm: Well water was ft. after hours pumping gpm
Bore Hole Diameter... 8 in. to 80 ft., and in. to ft.
WELL WATER TO BE USED AS: 5 Public water supply 8 Air conditioning 11 Injection well
1 Domestic 3 Feedlot 6 Oil field water supply 9 Dewatering 12 Other (Specify below)
2 Irrigation 4 Industrial 7 Lawn and garden only 10 Monitoring well
Was a chemical/bacteriological sample submitted to Department? Yes... No... X... If yes, mo/day/yr sample was submitted
Water Well Disinfected? Yes No X

5 TYPE OF BLANK CASING USED: 1 Steel 2 PVC 3 RMP (SR) 4 ABS 5 Wrought iron 6 Asbestos-Cement 7 Fiberglass 8 Concrete tile 9 Other (specify below) CASING JOINTS: Glued X Clamped Welded Threaded

Blank casing diameter... 4 in. to 60 ft., Dia... in. to ft., Dia... in. to ft.
Casing height above land surface... 0 in., weight... lbs./ft. Wall thickness or gauge No. Schedule 40

TYPE OF SCREEN OR PERFORATION MATERIAL: 1 Steel 2 Brass 3 Stainless steel 4 Galvanized steel 5 Fiberglass 6 Concrete tile 7 PVC 8 RMP (SR) 9 ABS 10 Asbestos-cement 11 Other (specify) 12 None used (open hole)

SCREEN OR PERFORATION OPENINGS ARE: 1 Continuous slot 2 Louvered shutter 3 Mill slot 4 Key punched 5 Gauzed wrapped 6 Wire wrapped 7 Torch cut 8 Saw cut 9 Drilled holes 10 Other (specify) 11 None (open hole)

SCREEN-PERFORATED INTERVALS: From... 60 ft. to 80 ft., From... ft. to... ft.
GRAVEL PACK INTERVALS: From... 15 ft. to 80 ft., From... ft. to... ft.

6 GROUT MATERIAL: 1 Neat cement 2 Cement grout 3 Bentonite 4 Other
Grout Intervals: From... 1 ft. to 15 ft., From... ft. to... ft., From... ft. to... ft.

What is the nearest source of possible contamination: 1 Septic tank 2 Sewer lines 3 Watertight sewer lines 4 Lateral lines 5 Cess pool 6 Sewage pit 7 Pit privy 8 Sewage lagoon 9 Feedyard 10 Livestock pens 11 Fuel storage 12 Fertilizer storage 13 Insecticide storage 14 Abandoned water well 15 Oil well/Gas well 16 Other (specify below)

Direction from well? southwest How many feet? 250'

FROM	TO	LITHOLOGIC LOG	FROM	TO	PLUGGING INTERVALS
0	6	Top Soil			
6	14	Clay			
14	25	Red Sands			
25	35	Medium sand			
35	37	Clays (Hard) & Sands			
37	52	Sugar Sands			
52	68	Fine Sands, Clay Mix			
68	72	White Sand, Clay Balls			
72	74	Tight Clay			
74	80	Water, Medium, Sand			

7 CONTRACTOR'S OR LANDOWNER'S CERTIFICATION: This water well was (1) constructed, (2) reconstructed, or (3) plugged under my jurisdiction and was completed on (mo/day/year) 5/25/92 CO 107 and this record is true to the best of my knowledge and belief. Kansas Water Well Contractor's License No. Puyear Contractors Inc. This Water Well Record was completed on (mo/day/yr) 6/1/92 under the business name of Puyear Contractors Inc. by (signature) James O. Puyear