


1 LOCATION OF WATER WELL: County: **Grant** Fraction: **SW 1/4 SW 1/4 SW 1/4** Section Number: **17** Township Number: **T 28 S** Range Number: **R 37 EW**

Distance and direction from nearest town or city street address of well if located within city?
From North Side of Ulysses - 1 Mile N. on Hwy. 25, 1-9/10ths Miles West & 400 Ft. North

2 WATER WELL OWNER: **Bill Rogers**
 RR#, St. Address, Box #: **901 N. McCall St.** Board of Agriculture, Division of Water Resources
 City, State, ZIP Code: **Ulysses, Kansas 67880** Application Number:

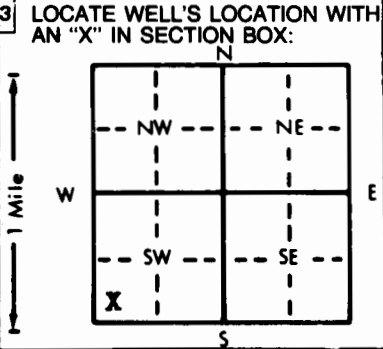

4 DEPTH OF COMPLETED WELL: **405** ft. ELEVATION: ft.
 Depth(s) Groundwater Encountered 1. ft. 2. ft. 3. ft.
 WELL'S STATIC WATER LEVEL **350** ft. below land surface measured on mo/day/yr **8-28-88**
 Pump test data: Well water was ft. after hours pumping gpm
 Est. Yield gpm: Well water was ft. after hours pumping gpm
 Bore Hole Diameter: **10-5/8"** in. to **405** ft., and in. to ft.
 WELL WATER TO BE USED AS:
 1 Domestic 3 Feedlot 6 Oil field water supply 9 Dewatering 12 Other (Specify below)
 2 Irrigation 4 Industrial 7 Lawn and garden only 10 Observation well
 Was a chemical/bacteriological sample submitted to Department? Yes.....No.....; If yes, mo/day/yr sample was submitted
 Water Well Disinfected? Yes No

5 TYPE OF BLANK CASING USED:
 1 Steel 3 RMP (SR) 5 Wrought iron 8 Concrete tile CASING JOINTS: Glued Clamped
 2 PVC 4 ABS 6 Asbestos-Cement 9 Other (specify below) Welded
 7 Fiberglass Threaded.....
 Blank casing diameter **6-5/8"** in. to **345** ft., Dia in. to ft., Dia in. to ft.
 Casing height above land surface **12** in., weight **12.89** lbs./ft. Wall thickness or gauge No. **.188**
 TYPE OF SCREEN OR PERFORATION MATERIAL:
 1 Steel 3 Stainless steel 5 Fiberglass 7 PVC 8 RMP (SR) 10 Asbestos-cement 11 Other (specify)
 2 Brass 4 Galvanized steel 6 Concrete tile 9 ABS 12 None used (open hole)
 SCREEN OR PERFORATION OPENINGS ARE:
 1 Continuous slot 3 Mill slot 5 Gauzed wrapped 8 Saw cut 11 None (open hole)
 2 Louvered shutter 4 Key punched 6 Wire wrapped 9 Drilled holes
 7 Torch cut 10 Other (specify)
 SCREEN-PERFORATED INTERVALS: From **345** ft. to **405** ft., From ft. to ft.
 From ft. to ft., From ft. to ft.
 GRAVEL PACK INTERVALS: From **25** ft. to **405** ft., From ft. to ft.
 From ft. to ft., From ft. to ft.

6 GROUT MATERIAL: 1 Neat cement 2 Cement grout 3 Bentonite 4 Other
 Grout Intervals: From **5** ft. to **25** ft., From ft. to ft., From ft. to ft.
 What is the nearest source of possible contamination:
 1 Septic tank 4 Lateral lines 7 Pit privy 10 Livestock pens 14 Abandoned water well
 2 Sewer lines 5 Cess pool 8 Sewage lagoon 11 Fuel storage 15 Oil well/Gas well
 3 Watertight sewer lines 6 Seepage pit 9 Feedyard 12 Fertilizer storage 16 Other (specify below) **NA**
 13 Insecticide storage
 Direction from well? How many feet?

FROM	TO	LITHOLOGIC LOG	FROM	TO	LITHOLOGIC LOG
		See attached log			

7 CONTRACTOR'S OR LANDOWNER'S CERTIFICATION: This water well was constructed, (2) reconstructed, or (3) plugged under my jurisdiction and was completed on (mo/day/year) **8-27-88** and this record is true to the best of my knowledge and belief. Kansas Water Well Contractor's License No. **208** This Water Well Record was completed on (mo/day/yr) **9-20-88** under the business name of **Minter-Wilson Drilling Co., Inc.** by (signature) *Nora Keller*

INSTRUCTIONS: Use typewriter or ball point pen. PLEASE PRESS FIRMLY and PRINT clearly. Please fill in blanks, underline or circle the correct answers. Send top three copies to Kansas Department of Health and Environment, Bureau of Water Protection, Topeka, Kansas 66620-7320, Telephone: 913-862-9360. Send one to WATER WELL OWNER and retain one for your records.

The
Professionals

MINTER-WILSON DRILLING CO.

INCORPORATED

and Domestic
Water Systems
Complete Installation
and Repairing

Phone 276-8269 • P.O. Box A • GARDEN CITY, KANSAS 67846

Bill Rogers
Grant County
8-23-88

Location: SW $\frac{1}{4}$ 17-28-37
From Ulysses North Side Black Top -
1 W., 1 N., $\frac{1}{4}$ 10th W. & 400' N.

Static Water Level - 350'

Test #1

0	11	Top soil
11	55	Brown clay
55	68	Fine sand
68	97	Brown clay
97	144	Brown sandy clay
144	224	Blue clay
224	230	Fine sand - loose
230	253	Brown sandy clay
253	265	Fine to medium sand & gravel - tight
265	292	Brown sandy clay
292	306	Brown clay - hard
306	324	Brown clay - tight
324	358	Brown clay white rock - tight
358	383	Brown clay - hard
383	398	Fine to medium sand & gravel - loose
398	407	Yellow clay

10-5/8" Hole
6-5/8" Steel Casing
345' Plain
60' Perf.