


1 LOCATION OF WATER WELL: Fraction NW 1/4 NE 1/4 NW 1/4 Section Number 21 Township Number T 28 S Range Number R 37 **E/W**  
 County: Grant

Distance and direction from nearest town or city street address of well if located within city?  
 3/4 mile west and 1 mile north of Ulysses, Kansas

2 WATER WELL OWNER: Charles Dew  
 RR#, St. Address, Box #: 204 S. Sullivan Board of Agriculture, Division of Water Resources  
 City, State, ZIP Code: Ulysses, Kansas 67880 Application Number:

3 LOCATE WELL'S LOCATION WITH AN "X" IN SECTION BOX:

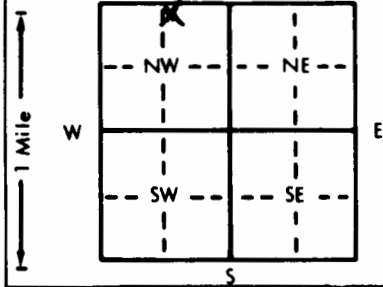

4 DEPTH OF COMPLETED WELL... 4.00 ft. ELEVATION: slope  
 Depth(s) Groundwater Encountered 1... 2.30 ft. 2... ft. 3... ft.  
 WELL'S STATIC WATER LEVEL .230 ft. below land surface measured on mo/day/yr 1/18/94  
 Pump test data: Well water was 2.30 ft. after 4 hours pumping 1.5 gpm  
 Est. Yield 5.0 gpm: Well water was ft. after hours pumping gpm  
 Bore Hole Diameter .12 1/2 in. to 4.00 ft., and in. to ft.  
 WELL WATER TO BE USED AS:  
 1 Domestic 3 Feedlot 6 Oil field water supply 9 Dewatering 12 Other (Specify below)  
 2 Irrigation 4 Industrial 7 Lawn and garden only 10 Monitoring well  
 Was a chemical/bacteriological sample submitted to Department? Yes No  X; If yes, mo/day/yr sample was submitted  
 Water Well Disinfected? Yes  X No

5 TYPE OF BLANK CASING USED:  
 1 Steel 3 RMP (SR) 5 Wrought iron 8 Concrete tile CASING JOINTS: Glued  X Clamped  
 2 PVC 4 ABS 6 Asbestos-Cement 9 Other (specify below) Welded  
 7 Fiberglass Threaded

Blank casing diameter 5 in. to 3.60 ft., Dia in. to ft., Dia in. to ft.  
 Casing height above land surface .18 in., weight schedule 200 PVC lbs./ft. Wall thickness or gauge No.

TYPE OF SCREEN OR PERFORATION MATERIAL:  
 1 Steel 3 Stainless steel 5 Fiberglass 8 RMP (SR) 10 Asbestos-cement  
 2 Brass 4 Galvanized steel 6 Concrete tile 9 ABS 11 Other (specify)  
 12 None used (open hole)

SCREEN OR PERFORATION OPENINGS ARE:  
 1 Continuous slot 3 Mill slot 5 Gauzed wrapped 8 Saw cut 11 None (open hole)  
 2 Louvered shutter 4 Key punched 6 Wire wrapped 9 Drilled holes  
 7 Torch cut 10 Other (specify)

SCREEN-PERFORATED INTERVALS: From 360 ft. to 400 ft., From ft. to ft.  
 From ft. to ft., From ft. to ft.  
 GRAVEL PACK INTERVALS: From 24 ft. to 400 ft., From ft. to ft.  
 From ft. to ft., From ft. to ft.

6 GROUT MATERIAL: 1 Neat cement 2 Cement grout 3 Bentonite 4 Other  
 Grout Intervals: From 4 ft. to 44 ft., From ft. to ft., From ft. to ft.

What is the nearest source of possible contamination:  
 1 Septic tank 4 Lateral lines 7 Pit privy 10 Livestock pens 14 Abandoned water well  
 2 Sewer lines 5 Cess pool 8 Sewage lagoon 11 Fuel storage 15 Oil well/Gas well  
 3 Watertight sewer lines 6 Seepage pit 9 Feedyard 12 Fertilizer storage 16 Other (specify below)  
 13 Insecticide storage field

Direction from well? How many feet?

FROM	TO	LITHOLOGIC LOG	FROM	TO	PLUGGING INTERVALS
0	2	Surface			
2	25	Sandy clay			
25	32	Brown clay			
32	42	Coarse sand			
42	90	Brown clay			
90	200	Blue clay			
200	240	Brown clay			
240	270	Medium to coarse sand			
270	320	Brown and blue clay			
320	345	Sandy clay			
345	375	Sandy clay w/fine sand			
375	400	Medium to coarse sand w/clay breakers			
400	405	Yellow chalk			

7 CONTRACTOR'S OR LANDOWNER'S CERTIFICATION: This water well was (1) constructed, (2) reconstructed, or (3) plugged under my jurisdiction and was completed on (mo/day/year) January 18, 1994 and this record is true to the best of my knowledge and belief. Kansas Water Well Contractor's License No. 164 This Water Well Record was completed on (mo/day/yr) Feb 25, 1994 under the business name of Houck Bros. Drlg. Co. by (signature) M. Beard

INSTRUCTIONS: Use typewriter or ball point pen. PLEASE PRESS FIRMLY and PRINT clearly. Please fill in blanks, underline or circle the correct answers. Send top three copies to Kansas Department of Health and Environment, Bureau of Water, Topeka, Kansas 66620-0001. Telephone: 913-296-5545. Send one to WATER WELL OWNER and retain one for your records.