USE TYPEWRITER OR BALL POINT PEN-PRESS FIRMLY, PRINT CLEARLY.

WATER WELL RECORD
KSA 82a-1201-1215

Kansas Department of Health and Environment-Division of Environment
(Water well Contractors)
Topeka, Kansas 66620

1. Location of well:	County	Fraction	Section number	Township number	Range number
	Grant	NE 1/4 NW 1/4 SE 1/4	24	T 28 S	R 37 E/W

2. Distance and direction from nearest town or city: from 4-way stop at Ulysses--1 mile north, 3 east ½ north
Street address of well location if in city:

3. Owner of well: Edward Dyck
R.R. or street: % W. D. Kimmel
City, state, zip code: First National Bank, Hutchinson, Ks. 67501

4. Locate with "X" in section below:

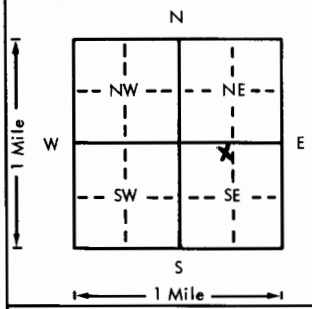

Sketch map:

5. Type and color of material	From	To
Surface	0	2
Clay	2	12
Gray clay and very fine sand	12	37
Gray clay	37	57
Very fine sand w/clay breakers	57	90
Sandy clay	90	102
Fine sand	102	105

(Use a second sheet if needed)

6. Bore hole dia. 12¼ in. Completion date 8/27/79
Well depth 42 ft.

7. __ Cable tool X Rotary __ Driven __ Dug
__ Hollow rod __ Jetted __ Bored __ Reverse rotary

8. Use: X Domestic __ Public supply __ Industry
__ Irrigation __ Air conditioning __ Stock
__ Lawn __ Oil field water __ Other

9. Casing: Material glued and ~~Rivited~~ Height: Above or below
Threaded ___ Welded ___ Surface 48 in.
RMP ___ PVC ___ Weight ___ lbs./ft.
Dia. 5 in. to 12 ft. depth Wall Thickness: inches or
Dia. ___ in. to ___ ft. depth gage No. .320

10. Screen: Manufacturer's name Sunflower
Type styrene Dia. 5"
Slot/gauze 1/16" Length 30 ft.
Set between 12 ft. and 42 ft.
___ ft. and ___ ft.
Gravel pack? X Size range of material ¼"

11. Static water level: 10 ft. below land surface Date 6/15/79 (mo./day/yr.)

12. Pumping level below land surfaces:
11 ft. after 12 hrs. pumping 10 g.p.m.
___ ft. after ___ hrs. pumping ___ g.p.m.
Estimated maximum yield 20 g.p.m.

13. Water sample submitted: ___ Yes X No Date ___ (mo./day/yr.)

14. Well head completion:
X Pitless adapter 14 Inches above grade

15. Well grouted? X
With: X Neat cement ___ Bentonite ___ Concrete
Depth: From 0 ft. to 10 ft.

16. Nearest source of possible contamination:
ft. 200 Direction north Type septic tank
Well disinfected upon completion? X Yes ___ No

17. Pump: X Not installed
Manufacturer's name ___
Model number ___ HP ___ Volts ___
Length of drop pipe ___ ft. capacity ___ g.p.m.
Type:
___ Submersible ___ Turbine
___ Jet ___ Reciprocating
___ Centrifugal ___ Other

18. Elevation:
Topography:
___ Hill
X Slope
___ Upland
___ Valley

19. Remarks:

20. Water well contractor's certification:
This well was drilled under my jurisdiction and this report is true to the best of my knowledge and belief.
Houck Bros. Drlg. Co. 164
Business name License No.
Address ~~Box 487, Ulysses, Ks.~~
Signed M. Beard Date 8/28/79
Authorized representative

T 28 R 37 E/W Sec 24 1/4 1/4 1/4 1/4 NENWSE

Forward the white, blue and pink copies to the Department of Health and Environment

Form WWC-5

MI-1023